


STATE OF KANSAS
STATE CORPORATION COMMISSION

Form CP-4

Give All Information Completely
Make Required Affidavit
Mail or Deliver Report to:
Conservation Division
State Corporation Commission
212 No. Market
Wichita, Kansas 67202

WELL PLUGGING RECORD

NORTH

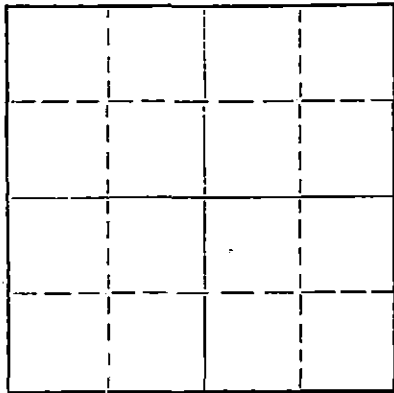

Locate well correctly on above
Section Plat

Pratt County, Sec. 20 Twp. 26 Rge. 12 (E) (W) x
Location as "NE/CNW&SW" or footage from lines SW NE SW
Lease Owner Robert L. Austin
Lease Name Hoeme Well No. #6
Office Address Box 159 Stafford, Kansas
Character of Well (completed as Oil, Gas or Dry Hole)
Date well completed 19
Application for plugging filed 19
Application for plugging approved 19
Plugging commenced 12-28-71 19
Plugging completed 1-6-72 19
Reason for abandonment of well or producing formation

If a producing well is abandoned, date of last production 19
Was permission obtained from the Conservation Division or its agents before plugging was commenced?

Name of Conservation Agent who supervised plugging of this well G. R. Biberstein
Producing formation Depth to top Bottom Total Depth of Well 4521' Feet
Show depth and thickness of all water, oil and gas formations.

OIL, GAS OR WATER RECORDS

CASING RECORD

FORMATION	CONTENT	FROM	TO	SIZE	PUT IN	PULLED OUT
				5 1/2"	4471'	2350.51'
				8 5/8"	263'	

Describe in detail the manner in which the well was plugged, indicating where the mud fluid was placed and the method or methods used in introducing it into the hole. If cement or other plugs were used, state the character of same and depth placed, from feet to feet for each plug set.

Made bottom hole plug back with sand to 4460'. Mixed and ran 5 sacks cement thru dump bailer.
Plugged hole with 2 sacks hulls - 15 sacks gel and 100 sacks cement to base of cellar.


RECEIVED
STATE CORPORATION COMMISSION
1-10-72
JAN 10 1972
CONSERVATION DIVISION
Wichita, Kansas

(If additional description is necessary, use BACK of this sheet)
Name of Plugging Contractor Southwest Casing Pulling Co.
Address Box 364 Great Bend, Kansas

STATE OF Kansas COUNTY OF Barton ss.
Southwest Casing Pulling Co. (employee of owner) or (owner or operator) of the above-described well, being first duly sworn on oath, says: That I have knowledge of the facts, statements, and matters herein contained and the log of the above-described well as filed and that the same are true and correct. So help me God.

(Signature) W. C. Lencer Sec.
Box 364 Great Bend, Kansas
(Address)

SUBSCRIBED AND SWORN TO before me this 7 day of January, 1972

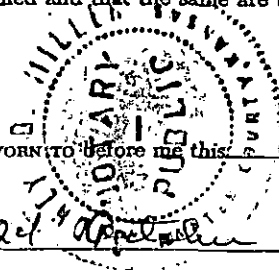

My commission expires 24 April 1972

Sidney D Miller
Notary Public.

8 5/8 265-3505, etc
 5 1/2 4471 150 "

November 3, 1952

4471 - 4521 - open No/E
 E/E. 1976 DF

Transit-N.C.R.A. # 6 Home
 SW NE SW Sec. 20-26S-12W
 Pratt County, Kansas

DRILLING TIME

3400-10	4	2	1	2	3	2	2	1	2	2
20	2	1	2	2	4	4	2	2	2	2
30	3	2	2	1	1	2	2	2	2	2
40	2	2	2	1	1	1	2	1	1	1
50	2	2	1	2	2	1	2	2	3	2
60	2	3	3	2	2	3	2	3	3	3
70	3	3	3	3	3	3	2	2	1	1
80	1	1	2	1	1	1	1	1	1	1
90	1	4	5	4	3	5	5	4	6	6
00	5	4	2	2	1	2	3	4	5	6
3500-10	6	5	5	3	2	2	2	2	4	5
20	7	5	3	4	3	5	4	5	5	7
30	3	3	3	3	3	2	3	7	4	3
40	4	4	5	5	4	3	2	2	2	2
50	2	2	3	2	2	2	4	3	4	4
60	4	4	5	5	4	5	4	5	3	4
70	4	5	5	5	4	5	5	5	7	6
80	7	6	7	7	7	6	7	8	7	8
90	8	8	6	6	7	7	9	8	10	9
00	9	8	8	10	10	9	10	11	11	10
3600-10	8	8	8	8	8	8	8	8	9	8
20	10	9	8	8	12	8	8	9	7	9
30	8	8	7	6	5	5	6	6	7	7
40	6	7	6	6	5	7	6	8	7	7
50	7	6	7	6	8	7	7	7	6	5
60	7	5	6	6	7	6	5	5	6	5
70	6	6	6	6	5	7	7	6	6	7
80	6	6	6	8	15	10	10	9	7	7
90	6	7	6	6	6	6	6	5	7	6
00	9	6	7	6	6	6	7	8	8	12
3700-10	7	6	6	5	5	7	6	6	6	6
20	7	7	7	8	7	7	6	7	6	4
30	4	6	6	4	4	5	4	4	4	6
40	5	4	4	5	4	7	7	8	6	7
50	8	7	7	7	5	4	6	4	5	5

6ix mud 3560-3599

Trip 3700, #7

3750-60 6 6 5 5 3 5 6 5 6 5
 70 8 9 11 10 5 7 7 7 8 10
 80 9 9 9 6 8 7 14 14 12 7
 90 11 11 12 11 11 12 14 11 13 13
 00 8 6 12 12 11 12 6 8 6 5 Twist-off 3793, new bit, #7

3800-10 5 5 5 6 5 4 3 3 7 3
 20 4 3 3 5 3 5 5 12 14 10
 30 14 13 12 5 8 5 5 5 6 7
 40 9 11 14 14 13 11 12 15 15 18
 50 16 18 17 19 15 8 7 13 15 10
 60 12 11 11 8 13 13 13 15 12 19
 70 12 12 10 10 8 6 6 8 8 9
 80 10 12 14 13 15 14 13 12 10 10 Circ. 3839
 90 8 6 5 6 6 6 5 10 11 11 Trip 3890, #7
 00 15 12 13 7 4 3 1 2 2 3

3900-10 3 3 5 8 12 11 12 15 15 17 Circ. 3904
 20 18 20 19 13 21 14 11 12 8 11
 30 13 16 20 12 6 12 19 15 13 10
 40 12 18 10 12 11 20 15 16 8 6
 50 5 2 5 8 12 14 14 18 18 12 Circ. 3945
 60 12 15 18 12 8 12 5 14 18 16
 70 19 11 13 10 7 10 7 5 7 6
 80 14 17 17 14 14 14 13 11 1 10
 90 10 9 12 10 11 11 10 6 10
 00 12 13 7 7 10 13 10 13 14 15

4000-10 10 14 9 9 9 15 14 15 14 13
 20 14 10 9 6 7 9 6 8 7 9
 30 5 6 7 6 5 5 5 11 14 12 Trip 4030, #7
 40 6 9 7 8 9 10 8 6 6 8
 50 7 10 10 15 12 16 19 15 15 10
 60 13 11 11 11 10 15 14 14 14 9
 70 9 13 16 16 17 13 14 15 11 12
 80 10 11 13 11 14 12 11 11 13 14 14
 90 15 14 15 16 16 17 6 5 5
 00 6 6 6 6 8 5 6 6 6 6

4100-10 6 6 7 7 7 8 8 8 8
 20 10 9 9 11 10 8 12 20 29 11 Trip 4119#78
 30 12 13 16 13 14 18 27 21 22 22
 40 19 16 15 13 11 12 14 13 9 11
 50 8 12 13 9 14 9 15 17 21 18

4150-60	16 19 15 20 22 20 23 22 19 25	
70	30 18 20 16 20 25 20 20 21 18	Trip 4162, 7a
80	11 7 9 11 9 9 8 8 7 11	
90	12 10 10 11 11 10 9 8 9 10	
00	9 9 12 10 8 12 11 13 12 10	
4200-10	19 19 19 19 6 7 8 6 7 6	Circ, DST, new WTR 4200
20	6 10 6 5 7 9 8 10 13 12 12	Killing on iron in hole
30	13 13 1 1 10 14 12 12 16 11	4200-05 (dropped piece of
40	11 14 10 26 21 14 10 11 18 18	chain in hole)
50	24 26 25 25 21 15 17 16 13 14	
60	24 17 20 9 6 4 9 5 8	Trip 4254, v7
70	8 12 11 10 9 14 6 13 11 15	
80	15 14 12 14 11 13 13 13 10 11	
90	13 12 11 13 15 17 17 15 14 13	
00	10 12 10 8 15 10 10 10 12 10	
4300-10	11 12 10 11 13 12 12 11 14 12	
20	11 11 13 15 12 12 13 13 18 9	Circ, Trip 4320, 1.7a
30	10 13 9 13 10 10 11 10 17 13	
40	8 21 15 15 13 18 17 16 21 19	Circ, DST, new bit 4340
50	13 18 13 14 15 9 11 13 15 14	
60	12 14 17 17 12 12 14 15 15 15	
70	12 12 12 7 11 15 13 16 14 14	
80	15 14 15 14 14 16 15 16 15 16	
90	15 14 14 15 13 12 12 13 14 8	
00	15 13 12 14 12 10 10 14 8 7 10	
4400-10	10 14 11 6 12 12 13 16 12 15	
20	13 16 19 15 11 15 17 17 20 15	
30	11 10 7 7 10 12 18 22 16 22	
40	21 22 22 15 10 9 11 13 9 23	
50	20 20 18 20 19 17 18 25	CD. Lost Circulation 4448.