


WELL PLUGGING RECORD

Give All Information Completely
Make Required Affidavit
Mail or Deliver Report to:
Conservation Division
State Corporation Commission
211 No. Broadway
Wichita, Kansas

PRATT County. Sec. 10 Twp. 26S Rge. (E) 11 (W)

Location as "NE/CNW/SW" or footage from lines. CENTER SW NW
Lease Owner. REX & MORRIS DRILLING CO., & HERNDON DRILLING CO.
Lease Name. BAUMAN Well No. 1
Office Address. P. O. BOX 334, EL DORADO, KANSAS
Character of Well (completed as Oil, Gas or Dry Hole) DRY HOLE
Date well completed 4 DECEMBER 19 62
Application for plugging filed 4 DECEMBER 19 62
Application for plugging approved 4 DECEMBER 19 62
Plugging commenced 4 DECEMBER 19 62
Plugging completed 4 DECEMBER 19 62
Reason for abandonment of well or producing formation DRY HOLE

NORTH

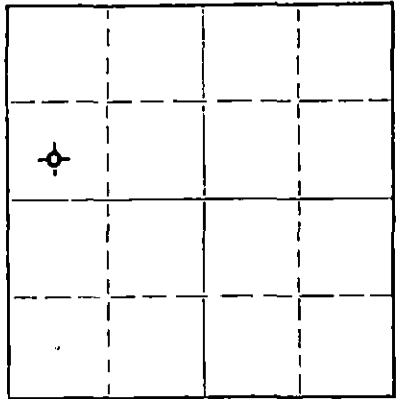

Locate well correctly on above
Section Plat

If a producing well is abandoned, date of last production. NONE 19
Was permission obtained from the Conservation Division or its agents before plugging was commenced? YES

Name of Conservation Agent who supervised plugging of this well HERMAN JUSTUS
Producing formation NONE Depth to top Bottom Total Depth of Well 4425' RB Feet
Show depth and thickness of all water, oil and gas formations.

OIL, GAS OR WATER RECORDS

CASING RECORD

FORMATION	CONTENT	FROM	TO	SIZE	PUT IN	PULLED OUT
SURFACE HOLE	WATER	SURFACE	253' RB	8 5/8"OD	248.10'	LEFT IN
(SEE ATTACHED LOG)						

Describe in detail the manner in which the well was plugged, indicating where the mud fluid was placed and the method or methods used in introducing it into the hole. If cement or other plugs were used, state the character of same and depth placed, from feet to feet for each plug set.

FILLED HOLE WITH DRILLING MUD TO 180', SET PLUG AND CEMENTED WITH 20 SACKS CEMENT, FILLED HOLE WITH DRILLING MUD TO 40', SET PLUG AND CEMENTED TO SURFACE WITH 10 SACKS CEMENT, PUT 2 SACKS CEMENT IN RAT HOLE.

STATE CORPORATION COMMISSION

DEC 26 1962

CONSERVATION DIVISION
Wichita, Kansas

(If additional description is necessary, use BACK of this sheet)
Name of Plugging Contractor. REX & MORRIS DRILLING COMPANY
Address. P. O. BOX 334, EL DORADO, KANSAS

STATE OF KANSAS COUNTY OF BUTLER, ss.
A. H. FISHER (employee of owner) or (owner or operator) of the above-described well, being first duly sworn on oath, says: That I have knowledge of the facts, statements, and matters herein contained and the log of the above-described well as filed and that the same are true and correct. So help me God.

(Signature) *A. H. Fisher*

P. O. BOX 334, EL DORADO, KANSAS
(Address)

SUBSCRIBED AND SWORN TO before me this 20TH day of DECEMBER, 19 62

My commission expires 8 AUGUST 1966
ELIZABETH DESCHNER Notary Public.



Elevation: 1845 RB
1842 DF

BAUMAN #1

Rex & Morris Drilling Co.
and
Herndon Drilling Co.

Total Depth: 4425
Contractor: Rex & Morris
Commenced: 11-24-62
Completed: 12-4-62
Initial Prod.: D. & A.

Location: C. SW NW
Section 10-26S-11W
Pratt County, Kansas

Casing Record:
8 5/8 @ 253' w/200 sacks

FORMATION	DEPTH
Surface Hole	253
Shale and Red Bed	1140
Shale	1750
Lime and Shale	2565
Shale and Lime	2805
Lime and Shale	3135
Shale and Lime	3320
Lime and Shale	3501
Sand	3533
Shale and Lime	3545
Shale	3591
Lime	4003
Lime and Shale	4046
Chert	4097
Lime	4140
Lime and Shale	4209
Shale and Lime	4242
Lime and Chert	4303
Lime	4367
Shale	4381
Sand	4398
Sand and Shale	4425

T.D.

Ran Welox GR-N-Guard.

STATE OF KANSAS
CORPORATION CO.

DEC 26 1962

CONSERVATION DIV
Pratt, Kansas

I hereby certify the foregoing statements are true and correct to the best of my knowledge and belief.

Rex & Morris Drilling Company

By Paul D. Koontz
Paul D. Koontz, Geologist

STATE OF KANSAS
COUNTY OF BUELER, SS.

Subscribed and sworn to before me, a Notary Public, this 7th day of December, 1962.

Elizabeth Deschner
Elizabeth Deschner, Notary Public

My commission expires: August 8, 1966.