


Give All Information Completely
Make Required Affidavit
Mail or Deliver Report to:
Conservation Division
State Corporation Commission
212 No. Market
Wichita, Kansas

WELL PLUGGING RECORD

NORTH

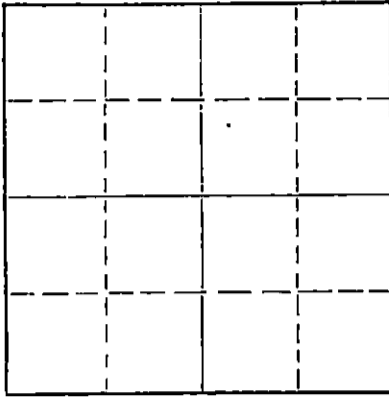

Locate well correctly on above
Section Plat

Pratt County, Sec. 6 Twp. 26S Rge. 14 (E) W(W)
Location as "NE/CNW&SWK" or footage from lines 1980' N of SL, 660' E of WL
Lease Owner Koch Exploration Company
Lease Name Foreman Well No. 1
Office Address P. O. Box 2256, Wichita, Kansas 67201
Character of Well (completed as Oil, Gas or Dry Hole) D & A
Date well completed February 26 1969
Application for plugging filed February 26 1969
Application for plugging approved February 26 1969
Plugging commenced February 26 1969
Plugging completed February 26 1969
Reason for abandonment of well or producing formation D & A

If a producing well is abandoned, date of last production _____ 19____
Was permission obtained from the Conservation Division or its agents before plugging was commenced? Yes

Name of Conservation Agent who supervised plugging of this well Ralph Warren
Producing formation _____ Depth to top _____ Bottom _____ Total Depth of Well 4435' Feet
Show depth and thickness of all water, oil and gas formations.

OIL, GAS OR WATER RECORDS

CASING RECORD

FORMATION	CONTENT	FROM	TO	SIZE	PUT IN	PULLED OUT
				8 5/8"	300.26	-0-

Describe in detail the manner in which the well was plugged, indicating where the mud fluid was placed and the method or methods used in introducing it into the hole. If cement or other plugs were used, state the character of same and depth placed, from _____ feet to _____ feet for each plug set.

Plugged hole w/50 sx
@ 500', 25 sx @ 300'
& 10 sx @ 40'

RECEIVED
STATE CORPORATION COMMISSION
MAR 12 1969
CONSERVATION DIVISION
Wichita, Kansas

(If additional description is necessary, use BACK of this sheet)

Name of Plugging Contractor Red Tiger Drilling Company
Address 1720 Wichita Plaza, Wichita, Kansas 67202

STATE OF Kansas, COUNTY OF Sedgwick, ss.
Norman E. Klein (employee of owner) or (owner or operator) of the above-described well, being first duly sworn on oath, says: That I have knowledge of the facts, statements, and matters herein contained and the log of the above-described well as filed and that the same are true and correct. So help me God.

(Signature) Norman E. Klein
1720 Wichita Plaza, Wichita, Kansas
(Address)

SUBSCRIBED AND SWORN TO before me this 6th day of March, 19 69

Gloria Dawett
Notary Public.

My commission expires 10-25-72



DRILLERS LOG

No. 1 Foreman

CASING RECORD:	COMPANY:	Koch Exploration Co.	DESCRIPTION:
8 5/8" @ 308'	CONTRACTOR:	Red Tiger Drilling Co.	1980' N of SL
w/320 .sx cement	COMMENCED:	February 12, 1969	660' E of WL
	COMPLETED:	February 26, 1969	6-26S-14W
			Pratt County,
			Kansas
TOTAL DEPTH: 4435'			ELEVATION:

<u>FORMATION</u>	<u>FROM</u>	<u>TO</u>	<u>REMARKS</u>
Surface Clay & Sand	0	60	
Sand	60	262	
Red Bed	262	440	
Red Bed w/Sand Stringers	440	933	
Anhydrite	933	948	
Sandy Red Bed	948	1330	
Shale	1330	1860	
Lime & Shale	1860	3095	
Lime	3095	3245	
Lime & Shale	3245	3760	
Lime	3760	4247	
Mississippi	4247	4315	
Lime & Shale	4315	4360	
Viola	4360	4435	

RECEIVED
STATE CORPORATION COMMISSION
MAR 12 1969
CONSERVATION DIVISION
Wichita, Kansas

I certify that this is a true and correct copy of the above log to the best of my knowledge.

RED TIGER DRILLING COMPANY

Norman E. Klein
Norman E. Klein

Subscribed and sworn to before me this 6th day of March, 1969.



Gloria Fawcett
Notary Public

My Commission Expires:
10-25-72