

Give All Information Completely
Make Required Affidavit
Mail or Deliver Report to:
Conservation Division
State Corporation Commission
211 No. Broadway
Wichita, Kansas

WELL PLUGGING RECORD

Pratt County, Sec. 7 Twp. 26 Rge. (E) 14 (W)

Location as "NE/CNW%SW%" or footage from lines c N/2 S/2 NW/4 7-26-14W

Lease Owner Halliburton Oil Producing Co.

Lease Name Abrams Unit Well No. 1

Office Address 117 Cameron Bldg., Oklahoma City, Okla. 73106

Character of Well (completed as Oil, Gas or Dry Hole) Dry Hole

Date well completed September 9 19 73

Application for plugging filed September 9 19 73

Application for plugging approved September 9 19 73


Plugging commenced September 9 19 73

Plugging completed September 9 19 73

Reason for abandonment of well or producing formation Dry Hole

If a producing well is abandoned, date of last production 19

Was permission obtained from the Conservation Division or its agents before plugging was commenced? Yes

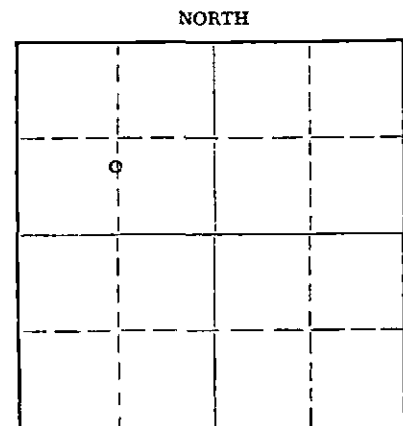

Locate well correctly on above Section Plat

Name of Conservation Agent who supervised plugging of this well G. R. Biberstein

Producing formation Depth to top Bottom Total Depth of Well 4252 Feet

Show depth and thickness of all water, oil and gas formations.

OIL, GAS OR WATER RECORDS

CASING RECORD

| FORMATION | CONTENT | FROM | TO | SIZE | PUT IN | PULLED OUT |
|-----------|---------|------|-----|--------|--------|------------|
| | | 0 | 290 | 8 5/8" | 290' | None |
| | | | | | | |
| | | | | | | |
| | | | | | | |
| | | | | | | |
| | | | | | | |
| | | | | | | |
| | | | | | | |
| | | | | | | |

Describe in detail the manner in which the well was plugged, indicating where the mud fluid was placed and the method or methods used in introducing it into the hole. If cement or other plugs were used, state the character of same and depth placed, from feet to feet for each plug set.

Plug:

- 500' w/40 sacks cement
- 275' w/25 sacks cement
- 40' w/15 sacks cement

RECEIVED
STATE CORPORATION COMMISSION

SEP 14 1973

CONSERVATION DIVISION
Wichita, Kansas

(If additional description is necessary, use BACK of this sheet)

Name of Plugging Contractor Hellar Drilling Company, Inc.

Address 339 Union Center Bldg., Wichita, Kansas 67202


STATE OF Kansas, COUNTY OF Sedgwick, ss.
D. L. Hellar, President of Hellar Drig. Co., Inc. (employee of owner) or (owner or operator) of the above-described well, being first duly sworn on oath, says: That I have knowledge of the facts, statements, and matters herein contained and the log of the above-described well as filed and that the same are true and correct. So help me God.

(Signature) D. L. Hellar, President
339 Union Center Bldg., Wichita, Kansas 67202
(Address)

SUBSCRIBED AND SWORN to before me this 13th day of September, 1973

My commission expires March 25, 1976.

Catherine Darcey
Notary Public.

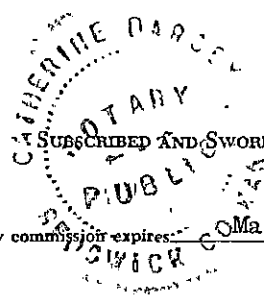

DRILLER'S LOG

COMPANY: Halliburton Oil Producing Co., 117 Cameron Bldg., Oklahoma City, Okla. 73106
CONTRACTOR: Hellar Drilling Company, Inc., 339 Union Center Bldg., Wichita, Kansas 67202
LEASE: #1 Abrams Unit
LOCATION: c N/2 S/2 NW/4 7-26-14W, Pratt County, Kansas
COMMENCED: August 27, 1973
COMPLETED: September 9, 1973
CASING: Set 8 5/8" Surface Casing @ 290' w/375 Sacks cement

| | |
|-----------|--------------------------------|
| 0-290 | Surface Soil & Sand |
| 290-951 | Shale & Red Bed |
| 951-961 | Anhydrite |
| 961-1582 | Shale & Red Bed & Sand |
| 1582-1915 | Shale w/Lime Streaks |
| 1915-2119 | Salt Section & Herrington |
| 2119-2241 | Salt Section & Shale |
| 2241-2415 | Shaley Lime (Ft. Riley) |
| 2415-2659 | Lime w/Shale Streaks |
| 2659-3276 | Lime & Shale |
| 3276-3432 | Lime (Topeka) |
| 3432-3655 | Lime |
| 3655-3822 | Lime & Shale |
| 3822-3855 | Lime & Shale (Lansing) L. K.C. |
| 3855-4000 | Lime |
| 4000-4065 | Lime (L. K.C.) |
| 4065-4095 | Lime |
| 4095-4194 | Lime w/Shale Streaks |
| 4194-4238 | Lime |
| 4238-4252 | Chert & Sand |
| 4252 | Rotary Total Depth |

D & A

RECEIVED
STATE CORPORATION COMMISSION
SEP 14 1973
CONSERVATION DIVISION
Wichita, Kansas

STATE OF KANSAS)
) SS
COUNTY OF SEDGWICK)

I, D. L. Hellar, do hereby certify that the above and foregoing is a true and correct copy of the log of the #1 Abrams Unit, located in c N/2 S/2 NW/4 7-26-14W, Pratt County, Kansas, as reflected by the files of the Hellar Drilling Company, Inc.

HELLAR DRILLING COMPANY, INC.

By *D. L. Hellar*
President - D. L. Hellar

Subscribed and sworn to before me, a Notary Public, in and for Sedgwick County, Kansas, this 13th day of September, 1973.

Catherine Darcey
Notary Public - Catherine Darcey

My Commission Expires:

March 25, 1976.