


STATE OF KANSAS  
STATE CORPORATION COMMISSION

WELL PLUGGING RECORD  
OR  
FORMATION PLUGGING RECORD

Give All Information Completely  
Make Required Affidavit  
Mail or Deliver Report to:  
Conservation Division  
State Corporation Commission  
800 Bitting Building  
Wichita, Kansas

Strike out upper line  
when reporting plug-  
ging off formations.

NORTH

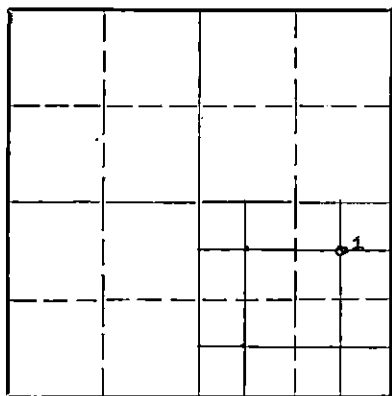

Locate well correctly on above  
Section Plat

Pratt County. Sec. 12 Twp. 26S Rge. 14W (E) (W)

Location as "NE 1/4 NW 1/4 SW 1/4" or footage from lines Center NE SE

Lease Owner The Texas Company

Lease Name B. Toland Well No. 1

Office Address 614 Bitting Bldg, Wichita, Kansas

Character of Well (completed as Oil, Gas or Dry Hole) Dry

Date well completed August 13, 19 44

Application for plugging filed August 12, 19 44

Application for plugging approved August 15, 19 44

Plugging commenced August 15, 19 44

Plugging completed August 15, 19 44

Reason for abandonment of well or producing formation Dry

If a producing well is abandoned, date of last production 19

Was permission obtained from the Conservation Division or its agents before plugging was commenced? Yes

Name of Conservation Agent who supervised plugging of this well Ruel E. Durkee

Producing formation Depth to top Bottom Total Depth of Well Feet

Show depth and thickness of all water, oil and gas formations.



OIL, GAS OR WATER RECORDS

CASING RECORD

Formation	Content	From	To	Size	Put In	Pulled Out
				13-3/8"	213'	

Describe in detail the manner in which the well was plugged, indicating where the mud fluid was placed and the method or methods used in introducing it into the hold. If cement or other plugs were used, state the character of same and depth placed, from feet to feet for each plug set.

Plugged with 20 sax cement at bottom and 10 sax cement at top of hole.

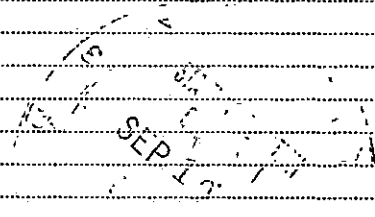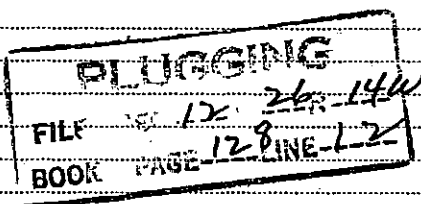

(If additional description is necessary, use BACK of this sheet)

Correspondence regarding this well should be addressed to The Texas Company  
Address 614 Bitting Bldg, Wichita, Kansas

STATE OF Kansas COUNTY OF Sedwick ss. M. C. Harrell (employee of owner) or (owner or operator) of the above-described well,

being first duly sworn on oath, says: That I have knowledge of the facts, statements, and matters herein contained and the log of the above-described well as filed and that the same are true and correct. So help me God.

(Signature) M. C. Harrell

614 Bitting Bldg, Wichita, Ks. (Address)

SUBSCRIBED AND SWORN to before me this 19th day of September, 19 44

My commission expires 8/26/45

Berthel W. Burt Notary Public.



# LOG OF WELL

Form PO-214 Sheet 1 (2-42) 10M

SHEET 1

OWNER The Texas Company DIVISION Oklahoma-Kans-Ky DATE MADE Sept 13, 1944  
 DISTRICT Kansas LEASE B. Toland WELL NO. 1  
 STATE Kansas COUNTY OR PARISH Pratt TWP. 25S RANGE 14W SEC. 12  
 LOCATION OF WELL Center N2 23

COMMENCED RIGGING UP 7/8/44 COMMENCED DRILLING 7/9/44 COMPLETED DRILLING 8/13/44  
 DAY DRILLER \_\_\_\_\_ NIGHT DRILLER \_\_\_\_\_ CONTRACTOR Holmerich & Payne  
 CABLE FROM \_\_\_\_\_ TO \_\_\_\_\_ ROTARY FROM 0 TO 4492' COMPANY RIG No. \_\_\_\_\_  
 TOTAL DEPTH 4492' MEASURED BY M. G. Harrell ELEVATION 1973

## CASING RECORD

SIZE	WEIGHT	PUT IN WELL		PULLED OUT		LOST IN WELL		SHOES		PACKERS			
		FEET	INS.	FEET	INS.	FEET	INS.	LENGTH	MAKE	KIND	LENGTH	SET AT	
													FT.
													FT.
WAS CASING CEMENTED? \_\_\_\_\_ IF SO, HOW MANY SACKS OF CEMENT USED? \_\_\_\_\_  
 LINER: STATE SIZE AND WEIGHT \_\_\_\_\_ WHERE SET \_\_\_\_\_ FT. AND INS. BLANK \_\_\_\_\_ FT. AND INS. PERFORATED \_\_\_\_\_  
 HOW PUT TOGETHER \_\_\_\_\_ COUPLING \_\_\_\_\_ FLUSH-JOINT \_\_\_\_\_ INSERTED \_\_\_\_\_  
 REMARKS: \_\_\_\_\_

## EQUIPMENT RECORD

TUBING				SUCKER RODS			PUMPING OUTFIT
SIZE	WEIGHT	FEET	INS.	FEET	INS.	SIZE AND KIND	DESCRIPTION, KIND, SIZE, ETC.

FLOWING, PUMPING, GASSER OR DRY Dry PRODUCTION FIRST 24 HOURS \_\_\_\_\_ PRODUCTION SETTLED \_\_\_\_\_  
 IF GAS WELL, OPEN FLOW CAPACITY \_\_\_\_\_ SHUT IN PRESSURE \_\_\_\_\_ ROCK PRESSURE \_\_\_\_\_  
 KIND OF SHOT \_\_\_\_\_ SIZE OF SHOT, QUARTS \_\_\_\_\_  
 NUMBER OF SHELLS \_\_\_\_\_ SIZE OF SHELLS **PLUGGING** INCHES, DIAMETER \_\_\_\_\_  
 LENGTH OF SHELLS \_\_\_\_\_ FEET \_\_\_\_\_ INCHES 12 26 140 TOP OF SHOT \_\_\_\_\_  
 BOTTOM OF SHOT \_\_\_\_\_ ANCHOR 12 8 LINE 12 WELL BRIDGED TO \_\_\_\_\_  
 TOTAL DEPTH OF WELL \_\_\_\_\_ NUMBER OF SHOT \_\_\_\_\_ PRODUCTION BEFORE SHOT \_\_\_\_\_ BBLs. PER DAY \_\_\_\_\_  
 PRODUCTION AFTER SHOT \_\_\_\_\_ BBLs. PER DAY. SHOT FURNISHED BY \_\_\_\_\_  
 NAME OF SHOOTER \_\_\_\_\_ SHOT INSPECTED \_\_\_\_\_ BY \_\_\_\_\_ (COMPANY EMPLOYEE)  
 COMMENCED DRILLING DEEPER \_\_\_\_\_ COMPLETED \_\_\_\_\_ DRILLING DEEPER \_\_\_\_\_  
 TOTAL DEPTH \_\_\_\_\_ PRODUCTION FIRST 24 HOURS \_\_\_\_\_ PRODUCTION SETTLED \_\_\_\_\_

REMARKS: Plugged with 20 sax at bottom and 10 sax at top --  
Lensing 318' - Cong. 4250' - Kenderhook 4302' - Viola 4340' - Stanton  
4400' - Arbuckle 4474'

NOTE: IF WELL WAS DRY, STATE UNDER REMARKS, WHEN, HOW, AND BY WHOM PLUGGED.  
 STATE UNDER REMARKS ANYTHING OF INTEREST NOT COVERED IN LOG.  
 IF THE SPACE PROVIDED FOR REMARKS IS NOT SUFFICIENT WRITE ON BOTTOM OF LAST SHEET OF LOG.

TOTAL NUMBER OF SHEETS \_\_\_\_\_

# LOG OF WELL

SHEET No. 1

District Kansas

Owner The Texas Company Farm B. Soland

Well No. 61

FORMATION	AMOUNT	COLOR	HARD OR SOFT	DEPTH CORES TAKEN	REMARKS
Sand & Clay	110				
Sand	180				
Red Bed	285				
Anhydrite	905				
Shale	965				
Shale & shells	1165				
Shale	1340				
Shale & shells	1415				
Salt & shale	1565				
Shale & shells	1800				
Lime & shale	1890				
Lime	2005				
Shale & lime	2100				
Lime	2192				
Lime & shale	2320				
Broken Lime	2398				
Lime & shale	2510				
Broken Lime & shale	2595				
Shale & Lime	2705				
Shale & shells	2778				
Shale & Lime	2865				
Shale & shells	2934				
Shale	2954				
Broken Lime	3024				
Shale & Lime	3048				
Shale & Lime shells	3115				
Broken Lime	3180				
Shale	3194				
Shale & Lime	3272				
Broken Lime	3300				
Lime & shale	3465				
Lime	3540				
Broken Lime	3595				
Lime	3620				
Shale & Lime	3782				
Shale & shells	3820				
Shale & Lime	3848				
K. O. Lime	3882				
Cherty Lime	3910				
Lime & Chert	3920				
Lime	3954				
Soft Lime	3959				
Lime	4068				
Shale	4072				
Lime	4102				
Shale & Lime	4132				
Shale & Lime	4150				
Broken Lime	4175				
Cherty Lime	4195				
Lime & shale	4205				
Sticky shale	4205				
Shale	4212				
Shale & Lime	4262				
Chert	4295				
Lime & chert	4362				
Shale	4380				
Cherty congl	4382				
Viola Lime	4375				
Lime	4398				
Simpson Sand	4474				
Artuokle	4494				
TOTAL DEPTH	4494				

**PLUGGING**  
 FILE REC 12-26R/4W  
 BOOK PAGE 128 LINE 12

