


STATE OF KANSAS
STATE CORPORATION COMMISSION

WELL PLUGGING RECORD

Give All Information Completely
Make Required Affidavit
Mail or Deliver Report to:
Conservation Division
State Corporation Commission
212 No. Market
Wichita, Kansas

PRATT County. Sec. 12 Twp. 26s Rge. 14 (E)X (W)
Location as "NE/CNW&SWX" or footage from lines C. NW NE
Lease Owner PETROLEUM, INC.,
Lease Name KIPP HEIRS Well No. 1
Office Address R. R. #2, GREAT BEND, KANSAS
Character of Well (completed as Oil, Gas or Dry Hole) DRY HOLE
Date well completed MARCH 1 19 69
Application for plugging filed MARCH 1 19 69
Application for plugging approved MARCH 1 19 69
Plugging commenced MARCH 1 19 69
Plugging completed MARCH 1 19 69
Reason for abandonment of well or producing formation NO PRODUCIBLE ZONE

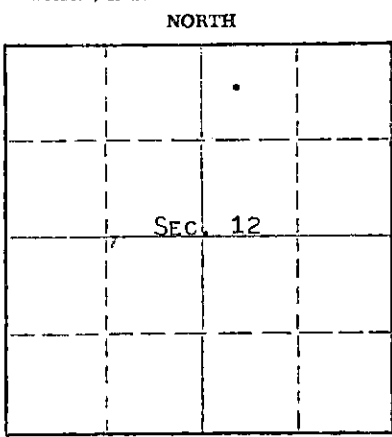

Locate well correctly on above
Section Plat

If a producing well is abandoned, date of last production NONE 19
Was permission obtained from the Conservation Division or its agents before plugging was commenced? YES

Name of Conservation Agent who supervised plugging of this well R. J. WARREN
Producing formation _____ Depth to top _____ Bottom _____ Total Depth of Well 4115 Feet
Show depth and thickness of all water, oil and gas formations.

OIL, GAS OR WATER RECORDS

CASING RECORD

FORMATION	CONTENT	FROM	TO	SIZE	PUT IN	PULLED OUT
				8-5/8"	289'	NONE

Describe in detail the manner in which the well was plugged, indicating where the mud fluid was placed and the method or methods used in introducing it into the hole. If cement or other plugs were used, state the character of same and depth placed, from _____ feet to _____ feet for each plug set.

HEAVY MUD TO 500', FOLLOWED WITH 50 SACKS CEMENT. 25 SACKS CEMENT TO 40',
1/2 SACK HULLS AND 1/2 SACK HULLS TO BRIDGE TO HOLD KELLY BUSHING FOLLOWED
WITH 10 SACKS CEMENT TO BASE OF WELL CELLAR.

RECEIVED
STATE CORPORATION COMMISSION
MAR 14 1969
CONSERVATION DIVISION
Wichita, Kansas

(If additional description is necessary, use BACK of this sheet)

Name of Plugging Contractor GARVEY DRILLING CO.
Address R. R. #2, GREAT BEND, KANSAS

STATE OF KANSAS, COUNTY OF BARTON, ss.

(employee of owner) or (owner or operator) of the above-described well, being first duly sworn on oath, says: That I have knowledge of the facts, statements, and matters herein contained and the log of the above-described well as filed and that the same are true and correct. So help me God.

(Signature)

Monte Chadd

R. R. #2, GREAT BEND, KANSAS
(Address)

SUBSCRIBED AND SWORN to before me this 13 day of MARCH, 1969

Richard H. Dumber

My commission expires MAY 28, 1969

Notary Public.

WELL LOG


COMPANY Petroleum, Inc.
FARM Kipp Heirs NO. 1
TOTAL DEPTH 4115'
COMM. 2-23-69 COMP. 3-1-69
CONTRACTOR Garvey Drilling Company

SEC. 12 T. 26S R. 14W

LOC. C NW NE

COUNTY Pratt Co., Kansas

CASING 8 5/8" @ 289' w/275 sx

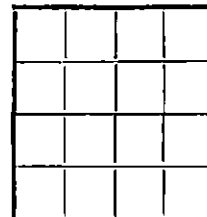

ELEVATION 1969' KB

PRODUCTION D & A

FIGURES INDICATE BOTTOM OF FORMATIONS

250' Sand & Shale
289' Red Bed
827' Shale
842' Anhydrite
1800' Shale
3879' Shale & Lime
4038' Lime
4115' Lime & Shale
4115' RTD

RECEIVED
STATE CORPORATION COMMISSION
MAR 14 1969
CONSERVATION DIVISION
Wichita, Kansas

State of Kansas }
County of Barton } es

I, Eunice McEachern of Garvey Drilling Company
upon oath state the above and foregoing is a true and correct copy of the log of the Kipp Heirs No. 1 well.

Eunice McEachern

Subscribed and sworn to before me this 7th day of March 19 69

My Commission Expires: November 5th, 1969

Richard S. Boyp
NOTARY PUBLIC