

15-151-18634-0000


WELL PLUGGING RECORD

Give All Information Completely  
Make Required Affidavit  
Mail or Deliver Report to:  
Conservation Division  
State Corporation Commission  
800 Biting Building  
Wichita, Kansas

Pratt

County, Sec. 30 Twp. 26S Rge. (E) 12 (W)

NORTH

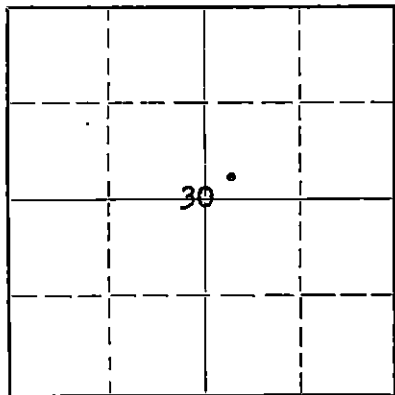

Locate well correctly on above Section Plat

Location as "NE/CNW%SW%" or footage from lines SW SW NE  
Lease Owner The British-American Oil Producing Company  
Lease Name A. Petrowsky Well No. 2  
Office Address P. O. Box 7497 Dallas, Texas  
Character of Well (completed as Oil, Gas or Dry Hole) Oil  
Date well completed 7-28 19 43  
Application for plugging filed 10-30 19 53  
Application for plugging approved 11-2 19 53  
Plugging commenced 11-10 19 53  
Plugging completed 12-9 19 53  
Reason for abandonment of well or producing formation Exhausted

If a producing well is abandoned, date of last production 8-12 19 53  
Was permission obtained from the Conservation Division or its agents before plugging was commenced? Yes

Name of Conservation Agent who supervised plugging of this well M. A. Rives  
Producing formation Arbuckle Limestone Depth to top 4280' Bottom 4309' GL Total Depth of Well 4309 Feet  
Show depth and thickness of all water, oil and gas formations. 4294' PBTB

OIL, GAS OR WATER RECORDS

CASING RECORD

FORMATION	CONTENT	FROM	TO	SIZE	PUT IN	PULLED OUT
Arbuckle Limestone	Oil	4280'	4309'	9-5/8"	559'	None
				5-1/2"	4283'	289'

Describe in detail the manner in which the well was plugged, indicating where the mud fluid was placed and the method or methods used in introducing it into the hole. If cement or other plugs were used, state the character of same and depth placed, from \_\_\_\_\_ feet to \_\_\_\_\_ feet for each plug set.

Plugged off Arbuckle section and filled hole with water. Shot 5 1/2" casing at 2215'. Well flowed water out of hole, then gas. Rigged up to kill well. Howce pumped 150 bbls. of fresh water into 5 1/2" casing at 450 psi, unable to kill well. Mixed and pumped in 297 sax of Magcobar weight material and 21 sax of gel with 135 bbls. water. Filled hole with rotary mud and added more mud as settling occurred. Ran 3" x 3' flat top shopmade bridging plug with wire line centralizers. Drove to 675'. Dumped 5 gallons crushed rock on plug then 20 sax cement which filled back to 510'. Waited 48 hours for cement to set by request of Kansas Corporation Commission. Rigged up hydraulic jacks and picked up on pipe; ran McCullough SM 1070 jet cutter, cut pipe off at 290', pulled approx. 289' of 5-1/2" casing. Plugged with heavy mud from 510' to 290', rock bridge from 290' to 280'; dumped 30 sax cement on rock bridge which filled from 280' to 190'. Filled hole with heavy mud from 190' to 65'; dumped 20 sax cement which filled to top of surface casing.

(If additional description is necessary, use BACK of this sheet)

Name of Plugging Contractor Pipe Pulling, Inc.  
Address Preston, Kansas

STATE OF Oklahoma COUNTY OF Oklahoma, ss.  
Fred Norris (employee of owner) or (~~owner or operator~~) of the above-described well, being first duly sworn on oath, says: That I have knowledge of the facts, statements, and matters herein contained and the log of the above-described well as filed and that the same are true and correct. So help me God.

(Signature) Fred Norris  
P. O. Box 3187, Oklahoma City, Oklahoma  
(Address)

SUBSCRIBED AND SWORN TO before me this 10th day of December 19 53

My commission expires 10-10-56 O. O. Floyd Notary Public.

PLUGGING  
FILE SEC 30 T 26 R 12W  
BOOK PAGE 139 NE 35

24-7368-S 3-53-20M

12-11-53  
CCNSP

15-151-10634-0000

A. PETROWSKY NO. 2

WELL LOG

Drilling Commenced: 6-21-43  
Drilling Completed: 7-25-53

9-5/8" Casing @ 558' KB  
5-1/2" OD Oil String 4289' KB

Initial Prod.: 143 BO in 6 hrs.

<u>From</u>	<u>To</u>	<u>Description</u>
0'	500'	Sand
500	568	Redbeds
568	796	Sand and Red Rock
796	1040	Red Rock
1040	1368	Sand, Shale and Shells
1368	1643	Sand and Shale
1643	1725	Shale
1725	3690	Lime and Shale
3690	3829	Lime
3829	3860	Lime and Shale
3860	3862	Lime
3862	4009	Lime and Shale
4009	4075	Lime
4075	4078	Lime and Chert
4078	4200	Hard Lime
4200	4275	Lime and Shale
4275	4313' KB	Lime
	TD	

FILED

10-31-53

**PLUGGING**  
FILE REC 50 T 26 P 126  
BOOK PAGE 39 LINE 35