

WELL PLUGGING RECORD

Give All Information Completely
Make Required Affidavit
Mail or Deliver Report to:
Conservation Division
State Corporation Commission
800 Bittling Building
Wichita, Kansas

Pratt County. Sec. 30 Twp. 26S Rge. 12 (E) (W)

Location as "NE/CNW 1/4 SW 1/4" or footage from lines 330 NSL and 330 EWL SW NE NE

Lease Owner The British-American Oil Producing Company

Lease Name Petrowsky

Well No. 4

Office Address P. O. Box 749, Dallas, Texas

Character of Well (completed as Oil, Gas or Dry Hole) Oil

Date well completed 9-14 19 43

Application for plugging filed 10-6 19 52

Application for plugging approved 10-7 19 52

Plugging commenced 11-9 19 52


Plugging completed 11-13 19 52

Reason for abandonment of well or producing formation

Reached economic limit.

If a producing well is abandoned, date of last production Oct. 19 51

Was permission obtained from the Conservation Division or its agents before plugging was commenced? Yes

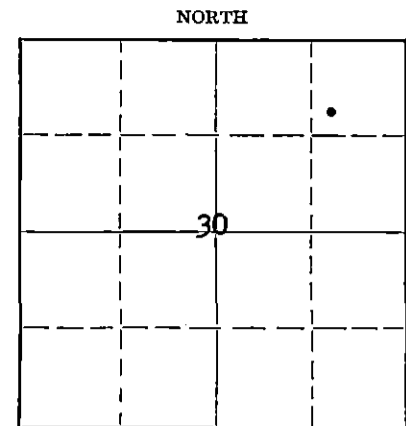

Locate well correctly on above Section Plat

Name of Conservation Agent who supervised plugging of this well M. A. Rives

Producing formation Simpson Depth to top 4187 Bottom 4193 Total Depth of Well 4304 Feet

Show depth and thickness of all water, oil and gas formations.

OIL, GAS OR WATER RECORDS

CASING RECORD

Formation	Content	From	To	Size	Put In	Pulled Out
Arbuckle	4291	4304'				270' 5 1/2'
Simpson *	4187	4193'				
*(Well plugged back to the Simpson zone in Oct. 1951)						

Describe in detail the manner in which the well was plugged, indicating where the mud fluid was placed and the method or methods used in introducing it into the hole. If cement or other plugs were used, state the character of same and depth placed, from _____ feet to _____ feet for each plug set.

Ran steel line to 4195', plugged back with sand from 4195' to 3970'; dumped 6 sacks cement from 3970 to 3922'. Filled hole with mud from 3922' to 270'. Placed rock bridge from 270' to 265'; dumped 20 sacks cement from 265' to 35'; placed rock bridge from 35' to 25'; dumped 9 sacks cement which filled to bottom of cellar.

(If additional description is necessary, use BACK of this sheet)

Correspondence regarding this well should be addressed to The British-American Oil Producing Company
Address Attention: Fred Norris, District Superintendent
P. O. Box 3187, Oklahoma City, Oklahoma

STATE OF Oklahoma, COUNTY OF Oklahoma, ss. Fred Norris (employee of owner) or (owner or operator) of the above-described well,

being first duly sworn on oath, says: That I have knowledge of the facts, statements, and matters herein contained and the log of the above-described well as filed and that the same are true and correct. So help me God.

(Signature) Fred Norris Dist. Supt.

P. O. Box 3187, Oklahoma City, Okla.

(Address)

SUBSCRIBED AND SWORN TO before me this 19th day of November 19 52

My commission expires 10-10-56

23-3273-s

RECEIVED
O. O. Floyd
CONSERVATION COMMISSION

Notary Public.

PLUGGING
FILE SEC 30 T 26 R 122
BOOK PAGE 50 LINE 26

NOV 20 1952
11-20-52
CONSERVATION DIVISION
KANSAS

15-151-10636-0000

WELL LOG

PETROWSKY #4

Location: 330' North of the South line and 330' East of the West line of the SW/4 of the NE/4 of the NE/4 of Section 30-26S-12W, Pratt County, Kansas

Ground Elevation 1918'
Top Arbuckle Lime 4287'
Total Depth 4304'

Drilling Commented 8-13-43
Drilling Completed 9-9-43

Casing Record: 9-5/8" OD surface casing cemented at 608' with 525 sacks.
5-1/2" OD oil string casing cemented at 4289' with 500 sacks.

<u>From</u>	<u>To</u>	<u>Formation</u>	<u>From</u>	<u>To</u>	<u>Formation</u>
0'	186'	Clay and sand	3906	3941	Lime and shale
186	426	Sand and clay	3941	4073	Lime
426	704	Redbeds	4073	4123	Chat and lime
704	804	Sand and Redbeds	4123	4151	Chat
804	1050	Shale & shells	4151	4195	Sandy shale
1050	1180	Shale and shells	4195	4230	Sandy lime and shale
1180	1341	Shale and shells	4230	4280	Sand and shale
1341	1700	Shale and sand	4280	4291	Shale and lime
1700	1833	Sand and shale	4291	4308	Arbuckle Lime (first show oil 4294-97')
1833	1935	Lime and shale			Total depth corrected to ground level.
1935	2065	Sandy lime and shale		4304	
2065	2163	Lime			
2163	2455	Lime and shale			
2455	2695	Shale and lime			
2695	2770	Lime and shale			
2770	2836	Sandy lime and shale			
2836	2969	Lime and shale			
2969	2995	Lime			
2995	3045	Sandy lime			
3045	3180	Shale and lime			
3180	3243	Lime and shale			
3243	3259	Sandy lime			
3259	3281	Lime			
3281	3358	Lime, slight odor, no stain			
3358	3474	Lime and shale			
3474	3566	Lime and shale streaks			
3566	3574	Lime and shale			
3574	3604	Sand			
3604	3693	Lime and shale			
3693	3711	Shale			
3711	3789	Lime and shale			
3789	3810	Lime			
3810	3826	Lime and shale			
3826	3906	Lime			

PLUGGING
FILE SEC 30 T 26 R 122
BOOK PAGE 50 LINE 26

007-71852
10-7-52
CONSERVATION DIVISION
Wichita, Kansas