


15-151-10641-0000

WELL PLUGGING RECORD

Give All Information Completely
Make Required Affidavit
Mail or Deliver Report to:
Conservation Division
State Corporation Commission
211 No. Broadway
Wichita, Kansas

Pratt County, Sec. 30 Twp. 26 Rge. 12W (X) (W)

Location as "NE/CNW/SW" or footage from lines SW SE SW
Lease Owner High Plains Production Company
Lease Name Schwertfeger Well No. 22
Office Address 300 Insurance Bldg., Wichita, Kansas
Character of Well (completed as Oil, Gas or Dry Hole) Oil
Date well completed 19
Application for plugging filed 19
Application for plugging approved 19
Plugging commenced 3-11 19 66
Plugging completed 3-14 19 66
Reason for abandonment of well or producing formation

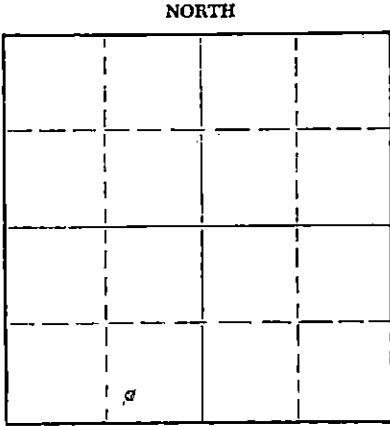

Locate well correctly on above Section Plat

If a producing well is abandoned, date of last production 19
Was permission obtained from the Conservation Division or its agents before plugging was commenced?

Name of Conservation Agent who supervised plugging of this well A. Elving
Producing formation Depth to top Bottom Total Depth of Well 4323' Feet
Show depth and thickness of all water, oil and gas formations.

OIL, GAS OR WATER RECORDS

CASING RECORD

FORMATION	CONTENT	FROM	TO	SIZE	PUT IN	PULLED OUT
						1225 ft.

Describe in detail the manner in which the well was plugged, indicating where the mud fluid was placed and the method or methods used in introducing it into the hole. If cement or other plugs were used, state the character of same and depth placed, from feet to feet for each plug set.

Sand to 4100 ft. -- dump 3 sax cement. -- pull 1225 ft. 4 1/2" pipe - mud to 300 ft.
10 ft. rock bridge - dump 4 yds. ready mix cement to surface.

RECEIVED
STATE CORPORATION COMMISSION

MAR 29 1966
3-29-66
Wichita, Kansas

(If additional description is necessary, use BACK of this sheet)

Name of Plugging Contractor
Address

STATE OF Kansas COUNTY OF Stafford, ss.
Ralph Comstock (employee of owner) or (owner or operator) of the above-described well, being first duly sworn on oath, says: That I have knowledge of the facts, statements, and matters herein contained and the log of the above-described well as filed and that the same are true and correct. So help me God.

(Signature) Ralph Comstock
Stafford, Ks.
(Address)

SUBSCRIBED AND SWORN TO before me this 17 day of March, 1966

My commission expires June 4 - 1968

H M Brown
Notary Public.



15-151-10641-0000


COPY

SHELL OIL CO., INC.
 M. Schwertfeger No. 2.

SEC. 30 T. 26. R. 12 W
 SW SE SW
 350' f SL 945' f EL SW 1/2

Total Depth. 4323'
 Comm. 5-21-43 Comp. 6-28-43
 Shot or Treated.
 Contractor.
 Issued. 8-21-43

County. Pratt

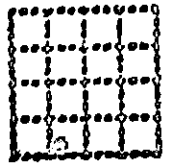

CASING:
 8 5/8" 819' Cem.
 4 1/2" 4290'

Elevation.

Production. Pot. 3000 B.

Figures Indicate Bottom of Formations. (Ind. Cap. DD Depth. 14, 271B.)

surface clay	60
sand & shale	256
shale & shells	475
redrock	669
red rock, shells	819
shale & shells	1270
salt & shale	1520
shale & shells	1595
shale, shells, anhydrite	1795
lime & shale	2011
brkn lime & shale	2072
lime & shale	2125
lime & shale	2222
lime & chert	2269
lime	2400
lime & shale	2937
lime	3000
lime & shale	3070
lime	3130
lime & shale	3185
lime	3558
lime & shale	3625
lime	4070
lime & chert	4193
lime	4211
lime & chert	4242
lime	4295
dolomite	4312
4312 equals 4311 SICorr.	
dolomite	4323
Total Depth.	

RECEIVED
 STATE CORPORATION COMMISSION

MAR 29 1966
 3-29-66
 RECEIVED BY DIRECTOR
 Wichita, Kansas

Tops: Lansing-K.C. 3689
 Arbuckle dol. 4291