

STATE OF KANSAS  
STATE CORPORATION COMMISSION


WELL PLUGGING RECORD

Give All Information Completely  
Make Required Affidavit  
Mail or Deliver Report to:  
Conservation Division  
State Corporation Commission  
800 Bittling Building  
Wichita, Kansas

OR  
FORMATION PLUGGING RECORD

Strike out upper line  
when reporting plug-  
ging of formations.

Pratt County. Sec. 3 Twp. 26S Rge. (E) 12(W)  
Location as "NE 1/4 NW 1/4 SW 1/4" or footage from lines SE SE SE  
Lease Owner. Kingwood Oil Company  
Lease Name. J. Hoskinson Well No. 1  
Office Address. Box 450, Effingham, Illinois  
Character of Well (completed as Oil, Gas or Dry Hole) Dry Hole  
Date, well completed. February 19, 1945 19  
Application for plugging filed. February 19, 1945, by telephone 19  
Application for plugging approved. February 19, 1945, by phone 19  
Plugging commenced. February 19, 1945 19  
Plugging completed. February 19, 1945 19  
Reason for abandonment of well or producing formation. Dry Hole

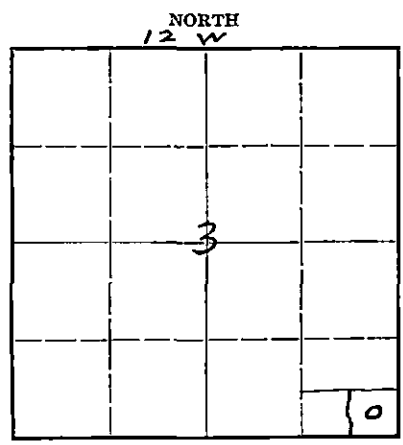

26  
S

Locate well correctly on above  
Section Plat

Name of Conservation Agent who supervised plugging of this well. Mr. Kerr  
Producing formation. None Depth to top. Bottom. Total Depth of Well 4350 Feet  
Show depth and thickness of all water, oil and gas formations.

OIL, GAS OR WATER RECORDS


CASING RECORD

Formation	Content	From	To	Size	Put In	Pulled Out
Surface Pipe	10 3/4" 32.75# (new.)	0	343'	10 3/4"	343'	none

Describe in detail the manner in which the well was plugged, indicating where the mud fluid was placed and the method or methods used in introducing it into the hold. If cement or other plugs were used, state the character of same and depth placed, from feet to feet for each plug set.

Hole mudded back to 343', set bridge, cemented with 15 sacks. Mudded back to 20' of top, set bridge and cemented with 10 sacks returning cement to bottom of cellar. Surface pipe was cut off at base of cellar and cement returned above this point.

PLUGGING  
FILE SEC 3 26 12 W  
BOOK PAGE 5 LINE 28

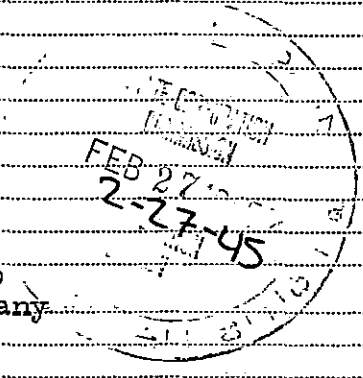

(If additional description is necessary, use BACK of this sheet)

Correspondence regarding this well should be addressed to Kingwood Oil Company  
Address. Box 450, Effingham, Illinois

STATE OF Kansas, COUNTY OF Barton, ss.  
I, G. W. Keyes, Drilling Contractor (employee of owner) or (owner or operator) of the above-described well, being first duly sworn on oath, says: That I have knowledge of the facts, statements, and matters herein-contained and the log of the above-described well as filed and that the same are true and correct. So help me God.

(Signature) G. W. Keyes  
Ellinwood, Kansas  
(Address)

NOT NOTARIZED

SUBSCRIBED AND SWORN to before me this Twentieth day of February, 1945  
My commission expires July 7, 1948  
Notary Public.

W E L L L O G

Kingwood Oil Co's J. Hoskinson et al #1, located in the Center of the Southeast Quarter (SE 1/4) of the Southeast Quarter (SE 1/4) of the Southeast Quarter (SE 1/4) of Section 3, Township 26 South, Range 12 West, Pratt County, Kansas.

Drilled by G. W. Keyes Drilling Company, Ellinwood, Kansas.

Figures indicate bottom of formations:

0 to 185 sand  
 235 red sand  
 344 red bed  
 550 red bed and shale  
 695 red bed  
 720 anhydrite  
 1320 shale and shells  
 1475 shale and salt  
 1745 shale and shells  
 1830 shale and lime  
 2050 lime  
 2120 shale and shells  
 2250 broken lime  
 2800 shale and shells  
 2970 broken lime  
 3060 lime and shale  
 3335 lime  
 3435 broken lime  
 3510 lime and shale  
 3535 lime  
 3570 shale and shells  
 3580 lime  
 3635 shale and shells  
 4060 lime  
 4090 shale  
 4200 lime  
 4220 lime and shale  
 4290 shale  
 4350 lime  
 4350 Total Depth

Started moving in January 25, 1945.  
 Started drilling January 27, 1945.  
 Set surface pipe January 28, 1945.  
 Total depth reached February 17, 1945.  
 Plugged as dry hole February 19, 1945.  
 Tore down rotary February 20, 1945.

FILED  
 3 26 1945  
 5 28

State of Kansas )  
 County of Barton ) ss

I, G. W. Keyes, partner of the above-mentioned G. W. Keyes Drilling Company, being first duly sworn on oath, declare: That I have knowledge of the facts, statements, and matters herein contained of the log of the above-described well as filed, and that the same are true and correct. So help me God.

(Signature) G. W. Keyes

(Address) Ellinwood, Kansas.

Subscribed and Sworn to before me this 26th day of February, 1945.

I. J. Rader  
 (Notary Public)

My commission expires July 7, 1948.

FEB 26 1945  
 2-27-45