

15-151-10684-0000


WELL PLUGGING RECORD

Give All Information Completely
Make Required Affidavit
Mail or Deliver Report to:
Conservation Division
State Corporation Commission
211 No. Broadway
Wichita, Kansas

Pratt County, Sec. 32 Twp. 26S Rge. XX 12(W)

Location as "NE/CNW%SW%" or footage from lines SW NE SE
Lease Owner Champlin Oil & Refining Co.
Lease Name Miskimen Well No. 2
Office Address P. O. Box 308, Ellinwood, Kansas, 67526
Character of Well (completed as Oil, Gas or Dry Hole) Oil
Date well completed April 28 1951
Application for plugging filed September 9 1964
Application for plugging approved September 10 1964
Plugging commenced September 29 1964
Plugging completed October 6 1964
Reason for abandonment of well or producing formation Non - Commercial
Production
If a producing well is abandoned, date of last production August 3 1964
Was permission obtained from the Conservation Division or its agents before plugging was commenced? Yes

NORTH

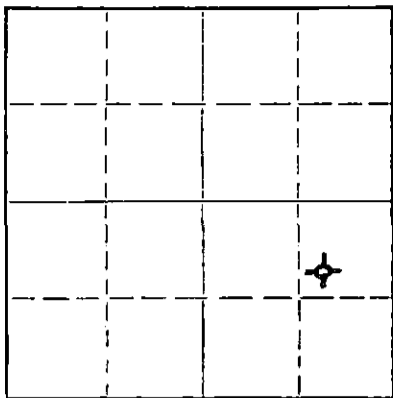

Locate well correctly on above
Section Plat

Name of Conservation Agent who supervised plugging of this well Archie Elving
Producing formation _____ Depth to top _____ Bottom _____ Total Depth of Well 4298 Feet
Show depth and thickness of all water, oil and gas formations.

OIL, GAS OR WATER RECORDS

CASING RECORD

FORMATION	CONTENT	FROM	TO	SIZE	PUT IN	PULLED OUT
				10 3/4" OD	800'	None
				5 1/2" OD	4270'	2073'

Describe in detail the manner in which the well was plugged, indicating where the mud fluid was placed and the method or methods used in introducing it into the hole. If cement or other plugs were used, state the character of same and depth placed, from _____ feet to _____ feet for each plug set.

Plugged back with sand from 4270' TD to 4160' and mixed and dumped

5 sacks of cement filling hole to 4120', then filled hole with mud to 310'

and set a 10' rock bridge and mixed and dumped 35 sacks of cement filling

hole to 230'. Mudded hole from 230' to 50' and set 10' rock bridge and mixed

and dumped 20 sacks of cement filling hole to base of cellar.

RECEIVED
STATE CORPORATION COMMISSION

OCT 14 1964
10-14-64
CONSERVATION DIVISION
Wichita, Kansas

(If additional description is necessary, use BACK of this sheet)

Name of Plugging Contractor Ace Pipe Pulling Co. (Permit #2)
Address P. O. Box 304, Great Bend, Kansas, 67530

STATE OF KANSAS, COUNTY OF BARTON, ss.

J. W. Meyers

(employee of owner) or (BY NOTARY PUBLIC) of the above-described well, being first duly sworn on oath, says: That I have knowledge of the facts, statements, and matters herein contained and the log of the above-described well as filed and that the same are true and correct. So help me God.

(Signature)

P. O. Box 308, Ellinwood, Kansas, 67526

(Address)

SUBSCRIBED AND SWORN to before me this 13th day of October, 1964.

W. Kenneth Stone

Notary Public.

My commission expires 5-22-66.

Champlin Oil & Refining Company
 Miskimen #2 Well
 990' FEL & 570' FNL of SE $\frac{1}{4}$ Sec.
 32-26S-12W
 Pratt County, Kansas

Formation Log

0'	-	430'	Sand - Shale - Shells
430'	-	790'	Shale - Shells
790'	-	815'	Anhydrite
815'	-	1585'	Shale - Shells
1585'	-	2460'	Shale
2460'	-	3195'	Lime - Shale
3195'	-	3265'	Lime
3265'	-	3400'	Lime - Shale
3400'	-	3570'	Lime
3570'	-	4040'	Lime - Shale
4040'	-	4075'	Lime
4075'	-	4115'	Chert - Lime - Shale
4115'	-	4150'	Chert - Lime
4150'	-	4220'	Shale - Sand
4220'	-	4230'	Sand
4230'	-	4269'	Shale
4269'	-	4272'	Lime
4272'	-	4298'	Lime
4298'	-		Total Depth

RECEIVED
 STATE CORPORATION COMMISSION

SEP 10 1964
 9-10-64
 CONSERVATION DIVISION
 Wichita, Kansas