

STATE OF KANSAS
STATE CORPORATION COMMISSION

WELL PLUGGING RECORD

Give All Information Completely
Make Required Affidavit
Mail or Deliver Report to:
Conservation Division
State Corporation Commission
800 Bittling Building
Wichita, Kansas

PRATT

County, Sec. 32 Twp. 26S. Rge. (E) 12. (W)

NORTH

Location as "NE/CNW $\frac{1}{4}$ SW $\frac{1}{4}$ " or footage from lines SH NW NE

Lease Owner SHELL OIL COMPANY

Lease Name E. V. MISKIMEN Well No. 1

Office Address BOX 714, GREAT BEND, KANSAS

Character of Well (completed as Oil, Gas or Dry Hole) OIL

Date well completed MARCH 27 19 43

Application for plugging filed AUGUST 12 19 53

Application for plugging approved AUGUST 13 19 53


Plugging commenced AUGUST 19 19 53

Plugging completed AUGUST 25 19 53

Reason for abandonment of well or producing formation OIL DEPLETED

If a producing well is abandoned, date of last production JULY 31 19 53

Was permission obtained from the Conservation Division or its agents before plugging was commenced? YES

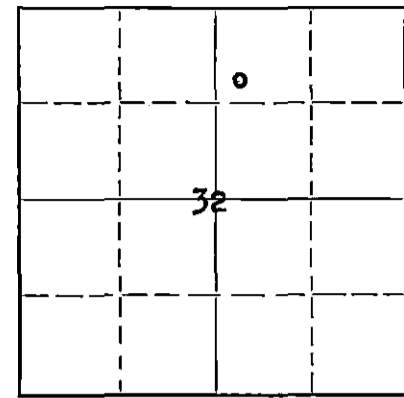

Locate well correctly on above
Section Plat

Name of Conservation Agent who supervised plugging of this well M. A. RIVES

Producing formation ARBUCKLE Depth to top 4274 Bottom Total Depth of Well 4320 Feet

Show depth and thickness of all water, oil and gas formations. PB 3811

OIL, GAS OR WATER RECORDS

CASING RECORD

| Formation | Content | From | To | Size | Put In | Pulled Out |
|---------------------|-----------------------------------------|------|------|---------------|------------|------------|
| ARBUCKLE | I.P. 8463 BO & 0 WTR/24 HRS; BHPB TEST. | 4277 | 4320 | 8 5/8" 4 1/2" | 545' 4277' | None 1843' |
| LANSING-KANSAS CITY | I.P. 0 OIL & 72 BW/24 HRS. PUMP. | 3772 | 3798 | | | |

Describe in detail the manner in which the well was plugged, indicating where the mud fluid was placed and the method or methods used in introducing it into the hole. If cement or other plugs were used, state the character of same and depth placed, from _____ feet to _____ feet for each plug set.

- (1) PB 4320-18 WITH LEAD WOOL. PB 4318-13 1/2 WITH WOOD LIMIT PLUG. PB 4313-12 WITH LEAD WOOL.
- (2) SET CIBP AT 4043. PB 4043-29 WITH 1 GAL. ROCK & 1 SACK CALSEAL.
- (3) SET CIBP AT 3920. PB 3920-10 WITH 1 SACK CALSEAL.
- (4) SET CIBP AT 3849. PB 3849-46 WITH 1/3 SACK CALSEAL.
- (5) SET CIBP AT 3825. PB 3825-11 WITH 1 SACK CALSEAL & 1/2 GAL. SANDSTONE.
- (6) FILLED HOLE WITH ROCK FROM 3811 TO 3760 & DUMPED 5 SACK CEMENT. MUDDED HOLE TO BOTTOM OF SURFACE CASING AT 545'. SQUEEZED SURFACE CASING WITH 20 SACK AQUAGEL & 100 SACK BULK CEMENT. MUDDED & CAPPED SURFACE CASING WITH 12 SACK CEMENT.

(If additional description is necessary, use BACK of this sheet)

Correspondence regarding this well should be addressed to SHELL OIL COMPANY
Address BOX 714, GREAT BEND, KANSAS

STATE OF KANSAS, COUNTY OF BARTON, SS.

S. S. MARRY (employee of owner) of the above-described well, being first duly sworn on oath, says: That I have knowledge of the facts, statements, and matters herein contained and the log of the above-described well as filed and that the same are true and correct. So help me God.

(Signature) *S. S. MARRY*

BOX 714, GREAT BEND, KANSAS
(Address)

SUBSCRIBED AND SWORN TO before me this 1st day of SEPTEMBER, 19 53.

My commission expires APRIL 11, 1956

L. M. Myers, Jr.
STATE OF KANSAS Notary Public.

PLUGGING
FBI SEC 22-T-26R-124
PAGE 121 LINE 28

09-03-53
CONSERVATION DIVISION
WICHITA, KANSAS

SHELL-E. V. MISKIMEN #1
SW NW NE Section 32-26S-12W
Iuka-Carmi Field
Pratt County, Kansas

CASING RECORD

8-5/8" cem 545 with 175 sax
4-1/2" cem 4277 with 380 sax; perforated
3787-98 & 3772-78

- 0 - 100 surface clay & sand
- 270 sand & gravel
- 380 redrock & shells
- 642 redrock & shale
- 732 redrock
- 752 anhydrite
- 910 redrock, shale & shells
- 966 redrock & shells
- 1103 redbeds & shells
- 1265 shale & lime streaks
- 1317 salt & shale
- 1541 shale & shells
- 1700 shale
- 1802 lime & shale
- 1891 anhydrite, shale & shells
- 1950 anhydrite & shale
- 1971 lime & shale with cherty streaks
- 2290 lime & shale
- 2330 lime cherty
- 2442 lime & shale
- 2502 lime
- 2792 lime & shale
- 2870 shale, lime & shells
- 2900 shale & lime
- 2933 lime
- 2967 lime & shale
- 3032 lime
- 3099 lime & shale
- 3180 lime & shale
- 3527 lime
- 3602 shale & lime
- 3639 lime
- 3764 lime & shale
- 3822 lime
- 3829 lime & chert streaks
- 4115 lime
- 4128 chert
- 4158 interbedded lime, shale & chert
- 4167 lime
- 4184 shale
- 4187 dolomite
- 4196 shale
- 4205 sand
- 4225 shale
- 4238 lime
- 4247 broken lime & shale
- 4278 dolomite
- 4320 dolomite TD
- 3811 PB

RECEIVED
REGISTRATION COMMISSION
AUG 13 1953
8-13-53

PLUGGING

FILE SEC 32 T 26 R 12W

BOOK PAGE 121 LINE 28