

15-151-10685-0000

STATE OF KANSAS  
STATE CORPORATION COMMISSION


Give All Information Completely  
Make Required Affidavit  
Mail or Deliver Report to:  
Conservation Division  
State Corporation Commission  
211 No. Broadway  
Wichita, Kansas

WELL PLUGGING RECORD

Pratt County, Sec. 32 Twp. 26S Rge. XX 12 (W)

Location as "NE/CNW&SW¼" or footage from lines. 2310' FEL 990' FSL  
Lease Owner Champlin Oil & Refining Co.  
Lease Name Miskimen Well No. 3  
Office Address P. O. Box 308, Ellinwood, Kansas, 67526  
Character of Well (completed as Oil, Gas or Dry Hole) Oil  
Date well completed December 10 19 49  
Application for plugging filed September 9 19 64  
Application for plugging approved September 10 19 64  
Plugging commenced September 15 19 64  
Plugging completed September 23 19 64  
Reason for abandonment of well or producing formation No oil production

NORTH

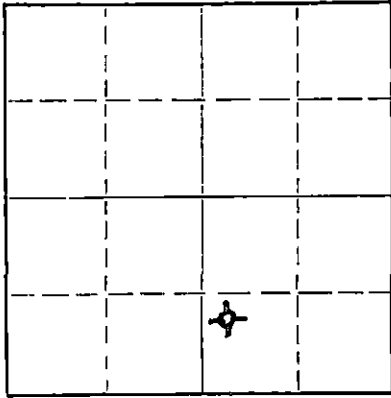

Locate well correctly on above  
Section Plat

If a producing well is abandoned, date of last production October 5 1958  
Was permission obtained from the Conservation Division or its agents before plugging was commenced? Yes

Name of Conservation Agent who supervised plugging of this well Archie Elving  
Producing formation \_\_\_\_\_ Depth to top \_\_\_\_\_ Bottom \_\_\_\_\_ Total Depth of Well 4305 Feet  
Show depth and thickness of all water, oil and gas formations. 4297' PBTB

OIL, GAS OR WATER RECORDS

CASING RECORD

FORMATION	CONTENT	FROM	TO	SIZE	PUT IN	PULLED OUT
				9 5/8" OD	711'	None
				5 1/2" OD	4304'	3181'

Describe in detail the manner in which the well was plugged, indicating where the mud fluid was placed and the method or methods used in introducing it into the hole. If cement or other plugs were used, state the character of same and depth placed, from \_\_\_\_\_ feet to \_\_\_\_\_ feet for each plug set.

Plugged back with sand from 4297' PBTB to 3655' and dumped 5 sacks cement to fill hole to 3615' then filled hole with mud to 310', set 10' rock bridge to 300', dumped 30 sacks cement filling hole to 225'. Then mudded hole to 40' and set rock bridge to 30' and dumped 15 sacks of cement filling hole to bottom of cellar.

RECEIVED  
STATE CORPORATION COMMISSION

SEP 30 1964  
7-30-64  
CONSERVATION DIVISION  
Wichita, Kansas

(If additional description is necessary, use BACK of this sheet)  
Name of Plugging Contractor Ace Pipe Pulling Co. (Permit #2)  
Address P. O. Box 304, Great Bend, Kansas, 67530

STATE OF KANSAS, COUNTY OF BARTON, ss.  
J. W. Meyers (employee of owner) or (owner or operator) of the above-described well, being first duly sworn on oath, says: That I have knowledge of the facts, statements, and matters herein contained and the log of the above-described well as filed and that the same are true and correct. So help me God.

(Signature) *J. W. Meyers*  
P. O. Box 308, Ellinwood, Kansas, 67526  
(Address)

SUBSCRIBED AND SWORN to before me this 29th day of September 19 64

My commission expires 5-22-66. *M. Kenneth Stover* Notary Public.

RECEIVED  
STATE CORPORATION COMMISSION  
SEP 10 1964  
9-10-64  
CONSERVATION DIVISION  
Wichita, Kansas

Champlin Oil & Refining Company  
Miskimen #3 Well  
2310' FEL & 990' FSL of SE $\frac{1}{4}$  Sec.  
32-26S-12W  
Pratt County, Kansas

## Formation Log

0'	-	230'	Surface Sand - Gravel
230'	-	385'	Redbed
385'	-	435'	Shale - Shells
435'	-	695'	Red Shale
695'	-	699'	Shale
699'	-	718'	Anhydrite
718'	-	928'	Redbed - Shells
928'	-	1128'	Shale - Shells
1128'	-	1220'	Salt - Shale
1220'	-	1610'	Salt - Shale - Shells
1610'	-	1685'	Shale - Salt
1685'	-	1865'	Anhydrite - Shale
1865'	-	1955'	Lime - Shale
1955'	-	2160'	Sand Lime - Shale
2160'	-	2215'	Lime
2215'	-	2490'	Lime - Shale
2490'	-	2730'	Shale - Shells
2730'	-	2930'	Shale - Lime
2930'	-	3055'	Lime
3055'	-	3118'	Lime - Shale
3118'	-	3150'	Sandy lime
3150'	-	3438'	Lime
3438'	-	3468'	Shale
3468'	-	3595'	Lime - Shale
3595'	-	3656'	Sandy Lime
3656'	-	3660'	Lime
3660'	-	3679'	Shale - Lime
3679'	-	3997'	Lime
3997'	-	4028'	Lime - Shale
4028'	-	4095'	Cherty Lime
4095'	-	4134'	Shale - Lime
4134'	-	4196'	Lime - Chert
4196'	-	4229'	Shale - Sand
4229'	-	4245'	Sandy Lime
4245'	-	4288'	Shale - Sand
4280'	-	4305'	Lime
4305'	-		Total Depth