

15-151-10688-0000

STATE OF KANSAS  
STATE CORPORATION COMMISSION

Give All Information Completely  
Make Required Affidavit  
Mail or Deliver Report to:  
Conservation Division  
State Corporation Commission  
211 No. Broadway  
Wichita, Kansas

WELL PLUGGING RECORD

Pratt

County. Sec. 32 Twp. 26S Rge. 12 (W)

Location as "NE/CNWSWK" or footage from lines SW/NE/NE

Lease Owner Shell Oil Company

Lease Name Miskimen Well No. 2

Office Address Box 744 - Great Bend, Kansas

Character of Well (completed as Oil, Gas or Dry Hole) Oil

Date well completed May 8, 19 43

Application for plugging filed October 3, 19 57

Application for plugging approved October 4, 19 57


Plugging commenced October 24, 19 57

Plugging completed November 5, 19 57

Reason for abandonment of well or producing formation Oil Depleted

If a producing well is abandoned, date of last production September 5, 19 57

Was permission obtained from the Conservation Division or its agents before plugging was commenced? Yes

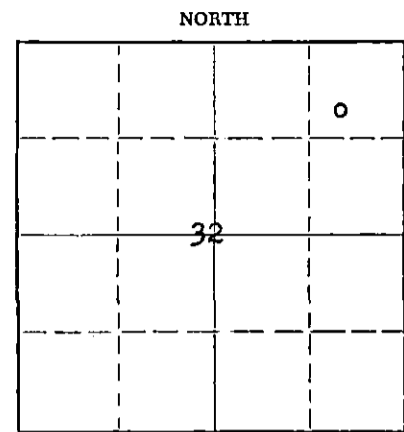

Locate well correctly on above Section Plat

Name of Conservation Agent who supervised plugging of this well M. A. Rives

Producing formation LKC Depth to top 3663 Bottom 3998 Total Depth of Well 4301 Feet

Show depth and thickness of all water, oil and gas formations. PB 3842

OIL, GAS OR WATER RECORDS

CASING RECORD

FORMATION	CONTENT	FROM	TO	SIZE	PUT IN	PULLED OUT
Arbuckle	IP 3000 BO & 0 Wtr 24 Hrs.	4255	4301	8-5/8"	880'	None
LKC	IP 15" BO, 87 BW, 24 Hrs.	3818	3825	4-1/2"	4255'	None

Describe in detail the manner in which the well was plugged, indicating where the mud fluid was placed and the method or methods used in introducing it into the hole. If cement or other plugs were used, state the character of same and depth placed, from \_\_\_\_\_ feet to \_\_\_\_\_ feet for each plug set.

PB w/ sand from 3842 to 3810. Dumped 4 sax cement to 3762. Mixed & pumped in 10 sax mud to 300. Set rock bridge to 290'. Mudded casing to 96 & pumped in 8 sax cement to bottom of cellar.

RECEIVED  
STATE CORPORATION COMMISSION

JAN 31 1958  
1-31-58  
CONSERVATION DIVISION  
Wichita 1958

(If additional description is necessary, use BACK of this sheet)

Name of Plugging Contractor Forbes Casing Pulling Company

Address Box 221 - Great Bend, Kansas

STATE OF Kansas, COUNTY OF Barton, ss.  
A. W. Weber (employee of owner) or (owner or operator) of the above-described

well, being first duly sworn on oath, says: That I have knowledge of the facts, statements, and matters herein contained and the log of the above-described well as filed and that the same are true and correct. So help me God.

(Signature) A. W. Weber

Post Office Box 744 - Great Bend, Kansas (Address)

SUBSCRIBED AND SWORN to before me this 29 day of January, 19 58

L. Mout Byers, Jr. Notary Public.

My commission expires January 28, 1961

PLUGGING  
FILE SEC 32 T 26 R 12 W  
BOOK PAGE 50 LINE 42

SHELL-E. V. MISKIMEN #2  
 SW NE NE Section 32-26S-12W  
 Iuka-Carmi Field  
 Pratt County, Kansas

Casing Record

8 5/8" cem 880 with 450 sax  
 4 1/2" cem 4255 with 1200 sax; perf 4190-4208,  
 4170-80, 3904-11, 3852-62 & 3818-25.

0 - 95 surface soil & sand  
 274 sand & red bed  
 575 red bed & shells  
 735 red bed & anhydrite  
 860 red bed & shells  
 875 red bed  
 880 shells  
 1030 red bed & shells  
 1300 shale & shells  
 1440 salt & shells  
 1740 salt & shale  
 1770 shale  
 2020 lime & shale  
 2093 lime  
 2195 lime & shale, cherty  
 2434 lime & shale  
 2515 shale  
 2615 lime & shale streaks  
 2872 shale  
 3020 lime & shale  
 3355 lime  
 3648 lime & shale  
 3742 lime  
 3790 lime, broken  
 3963 lime  
 4049 lime & shale  
 4074 lime & chert  
 4080 lime  
 4102 lime, shale & chert  
 4156 lime & chert  
 4191 shale & chert  
 4201 sand  
 4229 lime & chert  
 4255 lime & shale  
 4257 dolomite  
 4266 shale, pyritic, green, sandy  
 4273 dolomite, some sand  
 4279 dolomite  
 4293 dolomite, some sand & shale  
 4299 dolomite, some chert  
 4301 dolomite T.D.  
 3842 P.B.  
Formation Tops  
 Topeka 3177  
 Lansing-Kansas City 3663  
 Viola 4105  
 Simpson 4158  
 Arbuckle 4266

Plug Back Information

PB to 4281 with cement.  
 Set CIBP at 4235.  
 PB to 4216 with cement.  
 Set CIBP at 3950  
 PB to 3945 with rock & Calseal.  
 Set CIBP at 3890  
 Dump 1/2 sack CalSeal - no fillup.  
 Set CIBP at 3845.  
 PB to 3842 with rock & CalSeal.

PLUGGING

FILE SEC. 32 T. 26 R. 12W  
 BOOK PAGE 50 LINE 42

10-4-57