


15-151-18703-0000

STATE OF KANSAS  
STATE CORPORATION COMMISSION

WELL PLUGGING RECORD

Give All Information Completely  
Make Required Affidavit  
Mail or Deliver Report to:  
Conservation Division  
State Corporation Commission  
800 Bittling Building  
Wichita, Kansas

NORTH

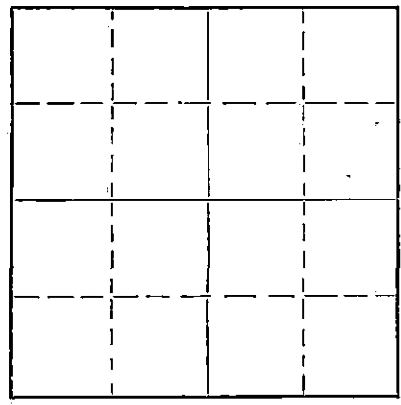

Locate well correctly on above  
Section Plat

Pratt County. Sec. 33 Twp. 26 Rge. 12 (W)

Location as "NE/CNW 1/4 SW 1/4" or footage from lines CW 1/2 NW SW

Lease Owner J. M. Huber Corporation

Lease Name Williams Well No. #1

Office Address P. O. Box 978 - Liberal, Kansas

Character of Well (completed as Oil, Gas or Dry Hole) Oil Well

Date well completed June 1945 19

Application for plugging filed 12-6-52 19

Application for plugging approved 12-6-52 19

Plugging commenced 12-7-52 19

Plugging completed 12-11-52 19

Reason for abandonment of well or producing formation  
No longer profitable to produce

If a producing well is abandoned, date of last production 10-30-52 19

Was permission obtained from the Conservation Division or its agents before plugging was commenced? Yes

Name of Conservation Agent who supervised plugging of this well Mr. M. A. Rives - Pratt, Kansas

Producing formation Depth to top Bottom Total Depth of Well 4293 1/2 Feet

Show depth and thickness of all water, oil and gas formations.

OIL, GAS OR WATER RECORDS

CASING RECORD

Formation	Content	From	To	Size	Put In	Pulled Out
				10 3/4"	814'	None
				5 1/2"	4288'	2234'

Describe in detail the manner in which the well was plugged, indicating where the mud fluid was placed and the method or methods used in introducing it into the hole. If cement or other plugs were used, state the character of same and depth placed, from feet to feet for each plug set.

Filled hole w/rock from 3740 to 3690 and dumped 5 sacks of cement.  
Loaded hole w/water. Shot #1 2448', #2, 2387', #3, 2275, and #4, 2213'  
Set fresh water plug at 275' and cemented w/20 sacks.  
Mudded hole to 35', set bridge and cemented w/10 sacks.

RECEIVED  
STATE CORPORATION COMMISSION  
DEPT. OF REVENUE  
CONSERVATION DIVISION  
WICHITA, KANSAS  
12-23-52

(If additional description is necessary, use BACK of this sheet)

Correspondence regarding this well should be addressed to J. M. Huber Corporation  
Address P. O. Box 978  
Liberal, Kansas

STATE OF KANSAS, COUNTY OF BRATT, SS.  
I, W. W. Henson (employee of owner) or (owner or operator) of the above-described well,

being first duly sworn on oath, says: That I have knowledge of the facts, statements, and matters herein contained and the log of the above-described well as filed and that the same are true and correct. So help me God.

(Signature) *W. W. Henson*

(Address)

SUBSCRIBED AND SWORN to before me this 21st day of December, 19 52

My commission expires September 10, 1955

*J. L. Rives*  
Notary Public

22-5133-s 9-48-10M

PLUGGING  
FILE SEC-33726 R 127  
BOOK PAGE 65 LINE 92

COPY

VEEDER SUPPLY & DEV'L. CO.

CHERRYVALE, KANSAS

Drilled for J. M. Huber Corporation

Farm Williams No. 1

Depth 4292'

Contractor Veeder Supply & Development Co.

Pipe 10-3/4" - 821' O.D. - 4288' of 5 1/2" Casing

Location c W/2 NW/4 SW/4 Sec. 33 Twp. 26S Range 12W

Commenced 3-11-45

Completed 4-9-45

County Pratt

State Kansas

FORMATION LOG

Surface Soil & Clay	0	170	170	Lime & shale	3030	3060	30
Sand	170	220	50	Shale & shells	3060	3150	90
Gravel	220	280	60	Shale	3150	3210	60
Red Bed	280	650	370	Lime & Shale	3210	3390	180
Sand	650	675	25	Lime	3390	3420	30
Red rock	675	713	38	Lime & shale	3420	3665	245
Red Bed	713	775	62	Lime	3665	3760	95
Anhydrite	775	814	39	Shale & lime	3760	3780	20
Shale & shells	814	1275	461	Lime	3780	3895	115
Salt	1275	1315	40	Lime & shale	3895	3985	90
Shale & shells	1315	1740	425	Shale	3985	4030	45
Lime	1740	1800	60	Shale & Lime	4030	4070	40
Lime - shells	1800	1865	65	Shale & cherty lime	4070	4085	15
Shale & shells	1865	2010	145	Cherty lime	4085	4115	30
Lime	2010	2040	30	Shale, lime-cherty	4115	4121	6
Shale & shells	2040	2100	60	Cherty lime	4121	4150	29
Lime	2100	2280	180	Cherty lime-shale	4150	4175	25
Lime-shale	2280	2320	40	Lime cherty	4175	4205	30
Lime	2320	2345	25	Cherty lime-shale	4205	4235	30
Lime & shale	2345	2680	335	Cherty lime	4235	4255	20
Shale & shells	2680	2990	310	Cherty lime, shale	4255	4285	30
Shale	2990	3030	40	Arbuckle	4285	4292	7

TOTAL DEPTH - 4,292'

AFFIDAVIT

STATE OF KANSAS )  
MONTGOMERY COUNTY ) SS:

EMMETT C. VEEDER, of lawful age, being duly and solemnly sworn on oath says:  
I am a resident of Cherryvale, Montgomery County, Kansas, and I hereby know and on oath state, that the above drilling log covering the Williams #1 well in Section 33-26S-12W, Pratt County, Kansas, is true and correct.

Further affiant saith not.

THE VEEDER SUPPLY & DEVELOPMENT COMPANY,

By: Emmett C. Veeder (signed)  
Present

Subscribed and sworn to before me this 14th day of April, 1945.

Cleo Conrad (signed)  
Notary Public

My Commission Expires: July 11, 1948

RECEIVED  
STATE OF KANSAS  
12-24-52  
CONCORDIA DIVISION  
MONTGOMERY COUNTY

WILLIAMS #1

SAMPLE TOPS - Measurements from drive bushing 2' above floor.

Top Brown lime 3665'  
 Top Lansing 3687'  
 Porosity, slight show oil 3715-22; 3784-91; 3836-43; 3870-77; 3882-94  
 HDST 3870-95, open 25 min. recovered 90' oil and gas cut mud.  
 Porosity, slight show oil, 3962-70.  
 Top Mississippi 4063'  
 Top Viola 4114' Corr. Correction 4125 equals 21.  
 Fair porosity, small show oil or gas, 4131-37.  
 HDST 4131-50, open 30 min. recovered 30' gas cut mud (fairly strong blow)  
 Top Simpson 4196'  
 Top Simpson sand 4222-27, fair porosity, very slight stain.  
 Top Arbuckle 4289-92, RTD. fair porosity, slight show oil.

5 1/2" casing cemented 4288' derrick floor.  
 Drilled cement and cleaned out 4292, rainbow show oil. Dumped 25 gal acid, set one hour, recovered rotary cuttings. Dumped 25 gal. acid, set overnight, found bottom 4295, recovered 25 gal. acid water and 30 gal. oil. 250 acid (1000 to 440#) swabbed down to 1200' off bottom. Shut down over nite and had 2000' FIH, 800' of which was oil. Bailer off bottom was acid water. Dowell Steel Line 4295' equals 4293 1/2. 250 gal. acid (100# to 425#) swabbed estimated 10 BOPH. Ran tubing and rods, put on pump. Pumped 26.3 BO/8 hours on State Potential. Completed for 79 BOPD, no water.

STATE OF KANSAS )  
 COUNTY OF SEDGWICK ) ss

I hereby certify that the above is a true and correct copy of the Sample Tops and Completion Date of the No. 1 Williams, located in the Center of the West Half of the Northwest Quarter of the Southwest Quarter (CW 1/2 NW SW) of Section 33, Township 26 South, Range 12 West, Pratt County, Kansas

VED  
 COMMISSION  
 625 1952  
 12-23-52  
 OBSERVATION DIVISION  
 Wichita, Kansas  
 Edward A. Huffman  
 District Manager  
 J. M. Huber Corporation

Subscribed and sworn to before me this 5th day of June, 1945

My Commission expires February 2, 1948

E. Jeanne Castleberry  
 Notary Public.

**PLUGGING**  
 FILE SEC-331-26R-124  
 BOOK PAGE 65 LINE 32