


STATE OF KANSAS
STATE CORPORATION COMMISSION

Give All Information Completely
Make Required Affidavit
Mail or Deliver Report to:
Conservation Division
State Corporation Commission
211 No. Broadway
Wichita, Kansas

WELL PLUGGING RECORD

Pratt County. Sec. 32 Twp. 26S Rge. (E) 12 (W)
Location as "NE/CNW/SW" or footage from lines SW SE NE
Lease Owner Shell Oil Company
Lease Name E. V. Miskimen Well No. 4
Office Address Box 744, Great Bend, Kansas
Character of Well (completed as Oil, Gas or Dry Hole) Oil
Date well completed April 10 19 44
Application for plugging filed October 3 19 57
Application for plugging approved October 4 19 57
Plugging commenced October 20 19 57
Plugging completed November 6 19 57
Reason for abandonment of well or producing formation Oil Depleted

NORTH

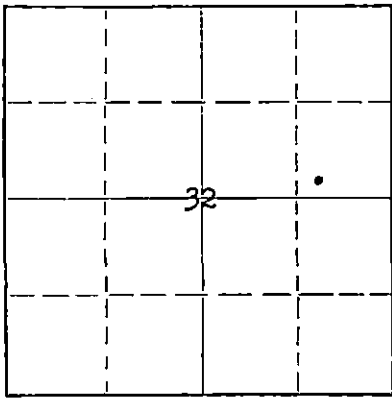

Locate well correctly on above
Section Flat

If a producing well is abandoned, date of last production September 2 19 57
Was permission obtained from the Conservation Division or its agents before plugging was commenced? Yes

Name of Conservation Agent who supervised plugging of this well M. A. Rives
Producing formation Lansing-Kansas City Depth to top 3659 Bottom - Total Depth of Well 4278 Feet
Show depth and thickness of all water, oil and gas formations. PB 3835

OIL, GAS OR WATER RECORDS

CASING RECORD

FORMATION	CONTENT	FROM	TO	SIZE	PUT IN	PULLED OUT
Arbuckle	IP 2985 B0 & 0 wtr 24 hr	4278	4303	8 5/8"	808'	None
Lansing-Kansas City	IP 5 B0 & 170 BW 24 hr	3823	3829	4 1/2"	4278'	891'

Describe in detail the manner in which the well was plugged, indicating where the mud fluid was placed and the method or methods used in introducing it into the hole. If cement or other plugs were used, state the character of same and depth placed, from _____ feet to _____ feet for each plug set.

Plugged back with sand to 3810 & dumped 4 sax cement to 3762.
Mixed & pumped 15 sacks mud to 240 and 20 sax cement to
bottom of cellar.

Handwritten notes and signatures:
FORBES CASING PULLING CO.
37 11 L. BEND, KANSAS
1-31-58

(If additional description is necessary, use BACK of this sheet)

Name of Plugging Contractor Forbes Casing Pulling Co.
Address Box 221, Great Bend, Kansas

STATE OF KANSAS, COUNTY OF BARTON, ss.
A. W. Weber (employee of owner) ~~owner or operator~~ of the above-described well, being first duly sworn on oath, says: That I have knowledge of the facts, statements, and matters herein contained and the log of the above-described well as filed and that the same are true and correct. So help me God.

(Signature) A. W. Weber
Box 744, Great Bend, Kansas
(Address)

SUBSCRIBED AND SWORN TO before me this 29th day of January, 19 58

My commission expires January 1, 1961
LaMont Byers Jr. Notary Public.

PLUGGING
FILE SEC 32 T 26 R 12 W
BOOK PAGE 50 LINE 44

SHELL-E. V. MISKIMEN #4
 SW SE NE Section 32-26S-12W
 Iuka-Carmi Field
 Pratt County, Kansas

Casing Record

8 5/8" cem 808 with 400 sax
 4 1/2" cem 4278 with 800 sax; perf 3823-29.

0 - 25 surface soil
 90 shale & shells
 280 sand & shells
 400 red bed, shale, sand
 630 red bed
 760 red bed & shells
 804 red bed & anhydrite
 1260 shale & shells
 1435 salt
 1685 salt & shells
 1755 shale & shells
 1865 shale & lime
 2080 lime & shale
 2170 lime, broken
 2228 lime, broken
 2288 lime & shale
 2355 lime
 2512 lime & shale
 2578 shale & lime
 2680 lime & shale
 2763 shale & lime
 2830 shale & shells
 3162 shale & lime
 3402 lime
 3540 lime & shale
 3603 lime, sandy
 3627 lime & shale
 3760 lime
 3815 lime & shale
 4068 lime
 4091 chert
 4121 chert & lime
 4153 lime & chert
 4173 chert & lime
 4196 lime & shale
 4227 shale & sand
 4272 shale & lime
 4279 lime & shale
 4303 dolomite TD
 3835 PB

Formation Tops

Topeka 3180
 Lansing-Kansas City 3659
 Viola 4102
 Simpson 4172
 Arbuckle 4275

Plug Back Information

PB to 4297 with sand & plastic.
 Set CIBP at 3850
 PB to 3835 with 1 sack cement.

10-4-57

PLUGGING	
FILE	SEC 32 T. 26 S. 12W
BOOK	PAGE 50 LI 44