


STATE OF KANSAS
STATE CORPORATION COMMISSION

Form CP-4

Give All Information Completely
Make Required Affidavit
Mail or Deliver Report to:
Conservation Division
State Corporation Commission
212 No. Market
Wichita, Kansas

WELL PLUGGING RECORD

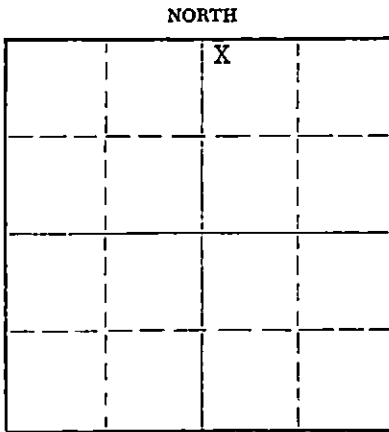

Locate well correctly on above
Section Plat

Pratt County. Sec. 29 Twp. 26S Rge. (E) 12 (W)
Location as "NE/CNW/SW" or footage from lines NW NW NE
Lease Owner Shell Oil Company
Lease Name Knop Well No. 5
Office Address 1700 Broadway, Denver, Colorado 80202
Character of Well (completed as Oil, Gas or Dry Hole) Oil
Date well completed May 5 19 52
Application for plugging filed July 18 19 69
Application for plugging approved July 22 19 69
Plugging commenced September 10 19 69
Plugging completed September 10 19 69
Reason for abandonment of well or producing formation Depleted

If a producing well is abandoned, date of last production September 19 66
Was permission obtained from the Conservation Division or its agents before plugging was commenced? Yes

Name of Conservation Agent who supervised plugging of this well R. J. Warren
Producing formation Lansing-Kansas City Depth to top 3687 Bottom 4270 Total Depth of Well 4306 Feet
Show depth and thickness of all water, oil and gas formations.

OIL, GAS OR WATER RECORDS

CASING RECORD

FORMATION	CONTENT	FROM	TO	SIZE	PUT IN	PULLED OUT
Lansing-Kansas City		3687	4270	8 5/8"	749'	None
				5 1/2"	4305'	None

Describe in detail the manner in which the well was plugged, indicating where the mud fluid was placed and the method or methods used in introducing it into the hole. If cement or other plugs were used, state the character of same and depth placed, from _____ feet to _____ feet for each plug set.
Mixed 20 SXS of Halco gels, 250 SXS of light cement and pumped down 5 1/2" casing. 10 psi surface press. Mixed 10 SXS of regular cement, pumped between 5 1/2" and 8 5/8" casing, surface press. 200 psi. Pumped 10 SXS regular cement down 5 1/2" casing, 16 psi surface press. Let set 2 days. Filled 5 1/2" casing with regular cement. Cut casing off 3 1/2' below surface. Welded on steel plate.

RECEIVED
STATE CORPORATION COMMISSION
SEP 30 1969
CONSERVATION DIVISION
Wichita, Kansas

(If additional description is necessary, use BACK of this sheet)

Name of Plugging Contractor Shell Oil Company
Address 1700 Broadway, Denver, Colorado 80202

STATE OF COLORADO, COUNTY OF DENVER, ss.
C. A. Wischoff (employee of owner) or (owner or operator) of the above-described well, being first duly sworn on oath, says: That I have knowledge of the facts, statements, and matters herein contained and the log of the above-described well as filed and that the same are true and correct. So help me God.

(Signature) C. A. Wischoff

Oklahoma Production Department
1700 Broadway (Address) Denver, Colorado 80202

SUBSCRIBED AND SWORN TO before me this 26th day of September, 1969

[Signature] Notary Public.

My commission expires April 23, 1973

DRILLERS LOG

Company -- Shell Oil Company,

Lease -- G Knop No. 5 Sec. 29-26S-12W. Pratt County, Kansas.

Contractor-- Adkins Drilling Company, Inc. Great Bend, Kansas.

Formation	From	To	Formation	From	To
Sand	0	185	Lime & Chert	4100'	4119'
Sand & Red Bed	185	500	Lime & Chert	4119'	4203'
Sand & Red Bed	500	738	Coring	4203'	4253'
Anhydrite	738	750'	Shale & Pyrite	4253'	4307'
Set 8 5/8" Surface pipe @ 749'			Total depth 4307'		
cemented with 400 sacks of cement			Set 5 1/2" Casing at 4306' cemented		
with 2% Jel.			with 200 sacks of cement.		
Plug	725'	726'			
Cement	726'	749'			
Open Hole	748	750'			
Anhydrite	750'	756'			
Shale & Red Bed	756'	1025'			
Gyp	1025'	1035'			
Red Bed shale & Shells	1035'	1550'			
Shale & Shells	1550'	1700'			
Lime & Shale	1700'	2825'			
Shale & Lime	2825'	3135'			
Lime & Shale	3135'	3546'			
Lime, Shale & Sand	3546'	3665'			
Lime & Shale	3665'	3680'			
Lime	3680'	3725'			
Lime & Shale	3725'	3769'			
Lime	3769'	4100'			

I hereby certify that the foregoing is a true and correct copy of the Drillers Log on the Knop # 5 test for Shell Oil Company located in the NW NW NE of Section 29 Twp 26S Range 12 West in Pratt County, Kansas.

Adkins Drilling Company, Inc.

By *Pauline B. Adkins*
Secy-Treas.

7-22-69
RECEIVED
STATE CORPORATION COMMISSION
JUL 22 1969
CONSERVATION DIVISION
Wichita, Kansas