


STATE OF KANSAS
STATE CORPORATION COMMISSION

WELL PLUGGING RECORD

Give All Information Completely
Make Required Affidavit
Mail or Deliver Report to
Conservation Division
State Corporation Comm.
245 North Water
Wichita, KS 67202

Pratt County, Sec. 29 Twp. 26 Rge. T2 W E/W
Location as "NE/CNW $\frac{1}{4}$ /SW $\frac{1}{4}$ " or footage from lines
SE SE SE
Lease Owner W. L. Kirkman Inc.
Lease Name Hoener Well No. I
Office Address P.O.Box I86II Wichita, Kansas 67207
Character of Well (Completed as Oil, Gas or Dry Hole)
oil

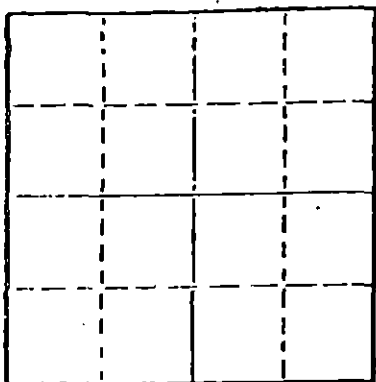

Locate well correctly on above
Section Plot

Date Well completed 7-3 1975
Application for plugging filed 7-27 1977
Application for plugging approved 7-28 1977
Plugging commenced 7-28 1977
Plugging completed 8-## I2 1977
Reason for abandonment of well or producing formation

If a producing well is abandoned, date of last production 19

Was permission obtained from the Conservation Division or
its agents before plugging was commenced? yes

Name of Conservation Agent who supervised plugging of this well Bill Owens
Producing formation Depth to top Bottom Total Depth of Well 3240'
Show depth and thickness of all water, oil and gas formations.

OIL, GAS OR WATER RECORDS

CASING RECORD

FORMATION	CONTENT	FROM	TO	SIZE	PUT IN	PULLED OUT
				5 1/2"		2,021'

Describe in detail the manner in which the well was plugged, indicating where the mud fluid
was placed and the method or methods used in introducing it into the hold. If cement or other
plugs were used, state the character of same and depth placed, from feet to
feet for each plug set. Plugged off bottom of hole with sand.

Sand from 3240 to 3075'. Dumped 5 sx of cement.
3 Hulls; 20 Gal; and 100 sx of cement, filling
to the bottom of the cellar.

RECEIVED
STATE CORPORATION COMMISSION
AUG 15 1977
8-15-77
CONSERVATION DIVISION
Wichita, Kansas

(If additional description is necessary, use BACK of this sheet)

Name of Plugging Contractor Art Lamb Casing Pulling Inc.
2809 King St. Hutchinson, Kansas 67501

STATE OF Kansas COUNTY OF Reno ss.
Art Lamb

(employee of owner) or (owner or operator) of the above-described
well, being first duly sworn on oath, says: That I have knowledge of the facts, statements, and matters herein contained and the log of the
above-described well as filed and that the same are true and correct. So help me God.

(Signature) Art Lamb
2809 King St. Hutchinson, Kansas
(Address)

SUBSCRIBED AND SWORN TO before me this 11th day of August 1977

My commission expires December 31, 1977

Judy Lamb
Notary Public.

15-151-19269-0000

DRILLERS LOG

HOENER #1

CASING RECORD:

8 5/8" set at 426'
w/375 sacks cement

TOTAL DEPTH:

3240'

OPERATOR: Wayne L. Kirkman

CONTRACTOR: Search Drilling Company

COMMENCED: June 27, 1975

COMPLETED: July 3, 1975

DESCRIPTION:

SE SE SE,
Sec.29-26S-12W
Pratt County,
Kansas

<u>FORMATION</u>	<u>FROM</u>	<u>TO</u>	<u>REMARKS</u>
Sand	0	426	
Shale	426	472	
Red Bed	472	1370	
Shale	1370	1800	
Lime and Shale	1800	1945	
Lime and Shale	1945	2003	
Lime and Shale	2003	2230	
Lime and Shale	2230	2400	
Lime and Shale	2400	2552	
Shale and Lime	2552	2705	
Shale and Lime	2705	2918	
Shale and Lime	2918	3066	
Shale and Lime	3066	3118	
Lime	3118	3135	
Lime	3135	3154	
Lime	3154	3240	Logged- laydown drill pipe - 102 joints 5 1/2" set at 3231' with 175 sacks common cement 10% salt preceded with 20 barrels salt flush -- plug down at 5:45 PM

RECEIVED
STATE CORPORATION COMMISSION

JUL 28 1977
7-28-77
CONSERVATION DIVISION
Wichita, Kansas

I certify that this is a true and correct copy of the above log to the best of my knowledge and belief.

SEARCH DRILLING COMPANY

M. A. Dressen
M. A. Dressen

Subscribed and sworn to before me this 8th. day of July, 1975.

Virginia S. Fabian
Virginia S. Fabian Notary Public

