


STATE OF KANSAS
STATE CORPORATION COMMISSION

Give All Information Completely
Make Required Affidavit
Mail or Deliver Report to:
Conservation Division
State Corporation Commission
800 Bittig Building
Wichita, Kansas

WELL PLUGGING RECORD

T 26S NORTH R 15W

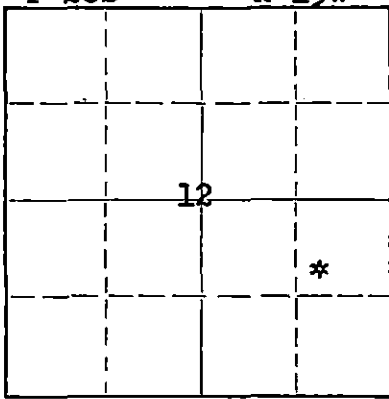

Locate well correctly on above
Section Flat

Pratt

County. Sec. 12 Twp. 26S Rge. 15W (E) (W)

Location as "NE/CNW%SW%" or footage from lines SW NE SE
Lease Owner R. W. Rine Drilling Company
Lease Name Gereke "A" Well No. 1
Office Address 320 Central Bldg. - Wichita, Kansas
Character of Well (completed as Oil, Gas or Dry Hole)
Date well completed 19
Application for plugging filed 19
Application for plugging approved 19
Plugging commenced March 5 19 56
Plugging completed March 8 19 56
Reason for abandonment of well or producing formation

If a producing well is abandoned, date of last production 19
Was permission obtained from the Conservation Division or its agents before plugging was commenced? Yes

Name of Conservation Agent who supervised plugging of this well Merle Rives
Producing formation Depth to top Bottom Total Depth of Well 4594 Feet
Show depth and thickness of all water, oil and gas formations.

OIL, GAS OR WATER RECORDS

CASING RECORD

FORMATION	CONTENT	FROM	TO	SIZE	PUT IN	PULLED OUT
				8-5/8"	420'	None
				5-1/2"	4567'	3284'
				Hole plugged back to 4036'. Casing perforated 3897' to 3903'.		

Describe in detail the manner in which the well was plugged, indicating where the mud fluid was placed and the method or methods used in introducing it into the hole. If cement or other plugs were used, state the character of same and depth placed, from feet to feet for each plug set.

Filled the hole with sand from 4036' to 3885' and ran 5 sacks of cement. Pulled casing up to 1700' and circulated hole with 30 sacks of jell mud. Bailed mud to 300', set a 10' rock bridge and ran 20 sacks of cement which filled to 230'. Mudded the hole to 35', set a 10' rock bridge and ran 10 sacks of cement which filled to the base of the cellar. Plugging completed.

(If additional description is necessary, use BACK of this sheet)
Name of Plugging Contractor West Supply Co., Inc.
Address Chase, Kansas

STATE OF KANSAS, COUNTY OF SEDGWICK, ss.
E. H. SLOYER (employee of owner) or (owner or operator) of the above-described well, being first duly sworn on oath, says: That I have knowledge of the facts, statements, and matters herein contained and the log of the above-described well as filed and that the same are true and correct. So help me God.

(Signature) E. H. SLOYER
320 Central Building, Wichita, Kansas
(Address)

SUBSCRIBED AND SWORN TO before me this 17th day of March, 1958

My commission expires June 14, 1958

Loren E. Lake Notary Public.
STATE COMMISSIONER

PLUGGING
FILE SEC. 12 T 26 R 15W
BOOK PAGE 40 LINE 31

MAR 19 1958
CONSERVATION DIVISION
Wichita, Kansas