

CARD MUST BE TYPED

State of Kansas
NOTICE OF INTENTION TO DRILL
(see rules on reverse side)

CARD MUST BE SIGNED

Starting Date: June 10 1985
month day year

API Number 15- 151-21,619-0000

OPERATOR: License # 6408
Name W.K. BLACK, INC.
Address P.O. BOX 801
City/State/Zip PRATT, KANSAS 67124
Contact Person WILLIAM K. BLACK
Phone 316-672-5712

SE SE SE/4 Sec 36. Twp 26. S, Rge 12. East West
(location)

330 Ft North from Southeast Corner of Section
330 Ft West from Southeast Corner of Section
(Note: Locate well on Section Plat on reverse side)

CONTRACTOR: License # 5829
Name ALDEBARAN DRILLING CO., INC.
City/State WICHITA, KANSAS

Nearest lease or unit boundary line 330 feet.
County Pratt
Lease Name Shriver Well# 1

Well Drilled For: Well Class: Type Equipment:
 Oil Swd Infield Mud Rotary
 Gas Inj Pool Ext. Air Rotary
 OWWO Expl Wildcat Cable

Domestic well within 330 feet: yes no
Municipal well within one mile: yes no

If OWWO: old well info as follows:
Operator
Well Name
Comp Date Old Total Depth
Projected Total Depth 4550 feet
Projected Formation at TD ARBUCKLE
Expected Producing Formations LAN-K.C.-MISS-SIMPSON

Depth to Bottom of fresh water 200 feet
Lowest usable water formation
Depth to Bottom of usable water 200 225 feet
Surface pipe by Alternate: 1 2
Surface pipe to be set 300 feet
Conductor pipe if any required 0 feet
Ground surface elevation 1858 feet MSL
This Authorization Expires 11-30-85


I certify that we will comply with K.S.A. 55-101, et seq., plus eventually plugging hole to K.C.C. specifications.

Date May 29, 1985
Signature of Operator or Agent

Approved By [Signature] Title PRESIDENT
RCH for KONE

Must be filed with the K.C.C. five (5) days prior to commencing well
This card void if drilling not started within six (6) months of date received by K.C.C.

A Regular Section of Land
1 Mile = 5,280 Ft.

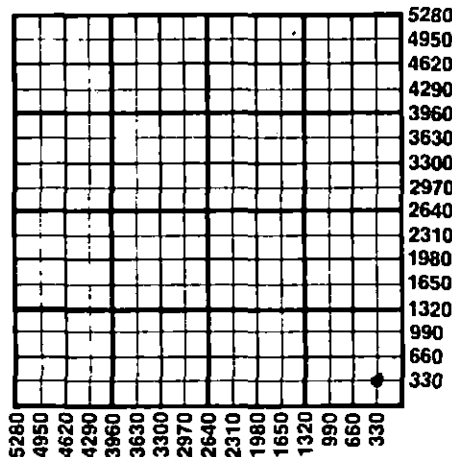

Important procedures to follow:

1. Notify District office before setting surface casing.
2. Set surface casing by circulating cement to the top.
3. File completion forms ACO-1 with K.C.C. within 90 days of well completion, following instructions on ACO-1, side 1, and including copies of wireline logs.
4. Notify District office 48 hours prior to old well workover or re-entry.
5. Prior to plugging, prepare a plugging plan, then obtain agreement from the appropriate district office for an approved plugging plan.
6. Submit plugging report (CP-4) to K.C.C. after plugging is completed.
7. Obtain an approved injection docket number before disposing of salt water.
8. Notify K.C.C. within 10 days when injection commences or terminates.
9. If an alternate 2 completion, cement in the production pipe from below any usable water to surface within 120 days of spud date.

RECEIVED
STATE CORPORATION COMMISSION
MAY 30 1985
5-30-85
CONSERVATION DIVISION
Wichita, Kansas

State Corporation Commission of Kansas
Conservation Division
200 Colorado Derby Building
Wichita, Kansas 67202
(316) 263-3238