

CARD MUST BE TYPED

State of Kansas

CARD MUST BE SIGNED

NOTICE OF INTENTION TO DRILL

(see rules on reverse side)

Expected Spud Date. December 19, 1987
month day yearAPI Number 15-151-21, 868-0000OPERATOR: License # 3633
Name MID CONTINENT DEVELOPMENT, INC.
Address 107 North Market - Suite 1115
City/State/Zip Wichita, Kansas 67202
Contact Person Kent Deutsch
Phone 316/267-7551SE SE NW Sec. 35 Twp. 26 S, Rg. 12 East
 West
2970 Ft. from South Line of Section
2970 Ft. from East Line of Section

(Note: Locate well on Section Plat on reverse side)

CONTRACTOR: License # 5929
Name DUKE DRILLING CO., INC.
City/State Great Bend, Kansas 67530Nearest lease or unit boundary 1330 feet
County PrattLease Name Mardis "G" Well # 1-35

Ground surface elevation _____ feet MSL

Domestic well within 330 feet: _____ yes noMunicipal well within one mile: _____ yes noDepth to bottom of fresh water 220Depth to bottom of usable water 220Surface pipe by Alternate: 1 2 _____Surface pipe planned to be set 300+

Conductor pipe required _____

Projected Total Depth 4300 feetFormation MississippianWell Drilled For: Well Class: Type Equipment:
 Oil _____ Storage Infield Mud Rotary
_____ Gas _____ Inj _____ Pool Ext. _____ Air Rotary
_____ OWWO _____ Expl _____ Wildcat _____ Cable

If OWWO: old well info as follows:

Operator _____

Well Name _____

Comp Date _____ Old Total Depth _____

I certify that well will comply with K.S.A. 55-101, et seq., plus eventually plugging hole to KCC specifications.

Date December 10, 1987 Signature of Operator or Agent Kent A. DeutschTitle AGENT

For KCC Use:


Conductor Pipe Required _____ feet; Minimum Surface Pipe Required 240 feet per Alt. 1This Authorization Expires 6-14-88 Approved By RCH 12-14-87EFFECTIVE DATE: 12-19-87

Must be filed with the K.C.C. five (5) days prior to commencing well
This card void if drilling not started within six (6) months of date received by K.C.C.

Important procedures to follow:

1. Notify District office before setting surface casing.
2. Set surface casing by circulating cement to the top.
3. File completion forms ACO-1 with K.C.C. within 120 days of well spud date, following instructions on ACO-1, side 1, and including copies of wireline logs.
4. Notify District office 48 hours prior to old well workover or re-entry.
5. Prior to filing Intent, prepare a proposed plugging plan in case well is D & A, then obtain approval of plan when calling district office prior to setting surface pipe.
6. Submit plugging report (CP-4) to K.C.C. after plugging is completed.
7. Obtain an approved injection docket number before disposing of salt water.
8. Notify K.C.C. within 10 days when injection commences or terminates.
9. If an alternate 2 completion, cement in the production pipe from below any usable water to surface within 120 days of spud date.

A Regular Section of Land
1 Mile = 5,280 Ft.

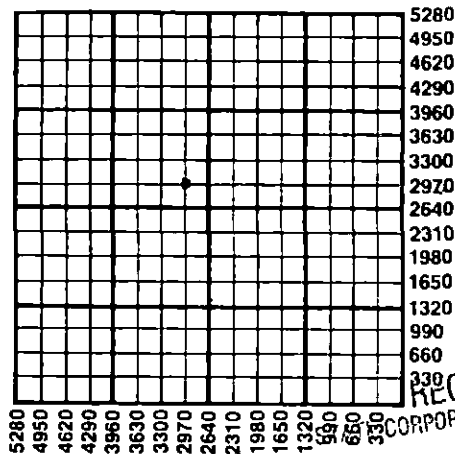

RECEIVED
CORPORATION COMMISSION
DEC 14 1987
12-14-87
CONSERVATION DIVISION
Wichita, Kansas

State Corporation Commission of Kansas
Conservation Division
200 Colorado Derby Building
Wichita, Kansas 67202-1212
(316) 263-3238