

CARD MUST BE TYPED

State of Kansas

CARD MUST BE SIGNED

NOTICE OF INTENTION TO DRILL

OWWO

(see rules on reverse side)

Expected Spud Date... November 8, 1987 month day year

API Number 15-151-21,804-A - 00-01

OPERATOR: License # 3180 Name DEUTSCH OIL COMPANY Address 105 North Market - Suite 1115 City/State/Zip Wichita, Kansas 67202 Contact Person Kent Deutsch Phone 316/267-7551

SW NW NE Sec. 35 Twp. 26 S, Rg. 12 East X West 4290 Ft. from South Line of Section 2310 Ft. from East Line of Section

(Note: Locate well on Section Plat on reverse side)

CONTRACTOR: License # 5929 Name DUKE DRILLING CO., INC. City/State Great Bend, Kansas 67530

Nearest lease or unit boundary line 330 feet County Pratt

Lease Name Mardis Well # 2-35 Ground surface elevation 1875 feet MSL

Well Drilled For: X Oil Storage X Infield X Mud Rotary Gas Inj Pool Ext Air Rotary X OWWO Expl Wildcat Cable

Domestic well within 330 feet: yes X no Municipal well within one mile: yes X no

Depth to bottom of fresh water 150

Depth to bottom of usable water 250

Surface pipe by Alternate: 1 X 2

If OWWO: old well info as follows: Operator Averada Corporation Well Name Mardis #2-35 Comp Date 10/16/86 Old Total Depth 4311

Surface pipe planned to be set 350

Conductor pipe required

Projected Total Depth 4311 feet

Formation

I certify that well will comply with K.S.A. 55-101, et seq., plus eventually plugging hole to KCC specifications.

Date 11/2/87 Signature of Operator or Agent Sally B. Byers Title Agent

For KCC Use:

Conductor Pipe Required 350 feet; Minimum Surface Pipe Required 350 feet per Alt. 1 X

This Authorization Expires 5-2-88 Effective 11-2-87 Approved By


Effective 11-2-87

Must be filed with the K.C.C. five (5) days prior to commencing well
This card void if drilling not started within six (6) months of date received by K.C.C.

Important procedures to follow:

1. Notify District office before setting surface casing.
2. Set surface casing by circulating cement to the top.
3. File completion forms ACO-1 with K.C.C. within 120 days of well spud date, following instructions on ACO-1, side 1, and including copies of wireline logs.
4. Notify District office 48 hours prior to old well workover or re-entry.
5. Prior to filing Intent, prepare a proposed plugging plan in case well is D & A, then obtain approval of plan when calling district office prior to setting surface pipe.
6. Submit plugging report (CP-4) to K.C.C. after plugging is completed.
7. Obtain an approved injection docket number before disposing of salt water.
8. Notify K.C.C. within 10 days when injection commences or terminates.
9. If an alternate 2 completion, cement in the production pipe from below any usable water to surface within 120 days of spud date.

A Regular Section of Land
1 Mile = 5,280 Ft.

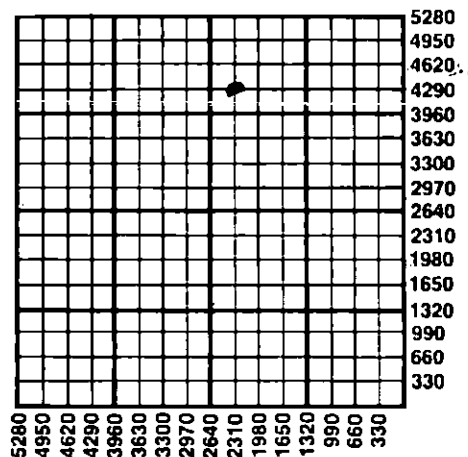

State Corporation Commission of Kansas
Conservation Division
200 Colorado Derby Building
Wichita, Kansas 67202-1212
(316) 263-3238