

CARD MUST BE TYPED

State of Kansas

CARD MUST BE SIGNED

## NOTICE OF INTENTION TO DRILL

4 1 86

(see rules on reverse side)

Starting Date .....  
month day year

API Number 15— 151-01,003-00-01

OPERATOR: License # 4864  
 Name AVERADA CORPORATION  
 Address 105 N. Market, Bitting Building, Suite 700  
 City/State/Zip Wichita, Kansas 67202  
 Contact Person Kent A. Deutsch  
 Phone 316/265-1401

NW NW NE ..... Sec. 35 Twp. 26 S, Rg. 12  East  
 West  
 4950 ..... Ft. from South Line of Section  
 2310 ..... Ft. from East Line of Section

(Note: Locate well on Section Plat on reverse side)

CONTRACTOR: License # 5864  
 Name LOBO DRILLING COMPANY  
 City/State Great Bend, Kansas 67530

Nearest lease or unit boundary line ..... 330 ..... feet  
 County Pratt  
 Lease Name Mardis Well # 1-35

Well Drilled For: Well Class: Type Equipment:  
 Oil  SWD  Infield  Mud Rotary  
 Gas  Inj  Pool Ext.  Air Rotary  
 OWWO  Expl  Wildcat  Cable

Ground surface elevation ..... ? ..... feet MSL  
 Domestic well within 330 feet:  yes  no  
 Municipal well within one mile:  yes  no

If OWWO: old well info as follows:

Depth to bottom of fresh water ..... 250 .....  
 Depth to bottom of usable water ..... 300 .....  
 Surface pipe by Alternate: 1  2

Surface pipe planned to be set ..... 693 .....

Conductor pipe required .....

Projected Total Depth ..... 4545 ..... feet

Formation ..... Arbuckle .....

I certify that well will comply with K.S.A. 55-101, et seq., plus eventually plugging hole to KCC specifications.

Date 3-25-86 ..... Signature of Operator or Agent *Kent A. Deutsch* ..... Title DISTRICT MANAGER .....

For KCC Use:


Conductor Pipe Required ..... feet; Minimum Surface Pipe Required ..... 300 feet per Alt. *1 2*This Authorization Expires 9-25-86 ..... Approved By 3-25-86 *RCA/KAS* .....

Must be filed with the K.C.C. five (5) days prior to commencing well  
This card void if drilling not started within six (6) months of date received by K.C.C.

**Important procedures to follow:**

1. Notify District office before setting surface casing.
2. Set surface casing by circulating cement to the top.
3. File completion forms ACO-1 with K.C.C. within 90 days of well completion, following instructions on ACO-1, side 1, and including copies of wireline logs.
4. Notify District office 48 hours prior to old well workover or re-entry.
5. Prior to filing Intent, prepare a proposed plugging plan in case well is D & A, then obtain approval of plan when calling district office prior to setting surface pipe.
6. Submit plugging report (CP-4) to K.C.C. after plugging is completed.
7. Obtain an approved injection docket number before disposing of salt water.
8. Notify K.C.C. within 10 days when injection commences or terminates.
9. If an alternate 2 completion, cement in the production pipe from below any usable water to surface within 120 days of spud date.

**A Regular Section of Land**  
1 Mile = 5,280 Ft.

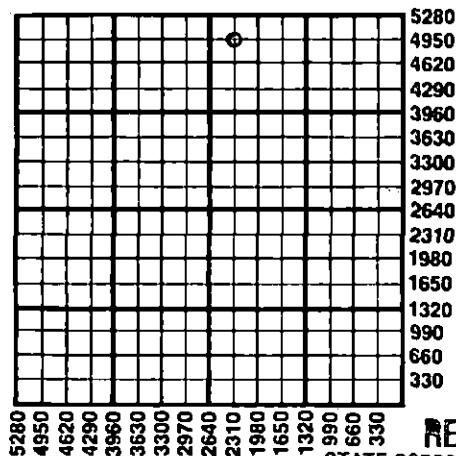

RECEIVED  
STATE CORPORATION COMMISSION

MAR 25 1986  
3-25-86  
CONSERVATION DIVISION  
Wichita, Kansas

State Corporation Commission of Kansas  
Conservation Division  
200 Colorado Derby Building  
Wichita, Kansas 67202  
(316) 263-3238