

CARD MUST BE TYPED

State of Kansas  
NOTICE OF INTENTION TO DRILL

CARD MUST BE SIGNED

*Correction*

*Corrected*

(see rules on reverse side)

*10-3-85*

Starting Date ..... 9      23      85  
   month      day      year

API Number 15— *151-21,717-0000*

OPERATOR: License # *9232*  
Name *Timberline Oil & Gas Corporation*  
Address *105 E. 8th Street*  
City/State/Zip *Pratt, Kansas 67124*  
Contact Person *Brant Grote or Roy Knappe, Jr.*  
Phone *(316) 672-9476*

*\*CW/2 NW SW* Sec. *35* Twp. *26* S, Rg. *12* East  
1980  West  
*\* 4950* Ft. from South Line of Section  
Ft. from East Line of Section

(Note: Locate well on Section Plat on reverse side)

CONTRACTOR: License # *5428*  
Name *Graves Drilling Co., Inc.*  
City/State *Wichita, KS*

Nearest lease or unit boundary line *330* feet  
County *Pratt*

Lease Name *G. Studer* Well # *2*

Ground surface elevation *1880* feet MSL

Well Drilled For:      Well Class:      Type Equipment:  
 Oil       SWD       Infield       Mud Rotary  
 Gas       Inj       Pool Ext.       Air Rotary  
 OWWO       Expl       Wildcat       Cable

Domestic well within 330 feet:       yes       no

Municipal well within one mile:       yes       no

Surface pipe by Alternate:      1  2

If OWWO: old well info as follows:

Depth to bottom of fresh water *240'*

Depth to bottom of usable water *260'*

Surface pipe planned to be set *300'*

Projected Total Depth *4400* feet

Formation *Viola*

I certify that well will comply with K.S.A. 55-101, et seq., plus eventually plugging hole to KCC specifications.

Date *10/2/85* Signature of Operator or Agent *[Signature]* Title *President*

*CW/2 NW SE*  
*kw. 35-27-12*  
*2310 FEL*

For KCC Use:

Conductor Pipe Required ..... feet; Minimum Surface Pipe Required ..... feet per Alt. 1 2


This Authorization Expires *3-27-86* Approved By *9-27-85*

Must be filed with the K.C.C. five (5) days prior to commencing well  
This card void if drilling not started within six (6) months of date received by K.C.C.

### Important procedures to follow:

1. Notify District office before setting surface casing.
2. Set surface casing by circulating cement to the top.
3. File completion forms ACO-1 with K.C.C. within 90 days of well completion, following instructions on ACO-1, side 1, and including copies of wireline logs.
4. Notify District office 48 hours prior to old well workover or re-entry.
5. Prior to filing Intent, prepare a proposed plugging plan in case well is D & A, then obtain approval of plan when calling district office prior to setting surface pipe.
6. Submit plugging report (CP-4) to K.C.C. after plugging is completed.
7. Obtain an approved injection docket number before disposing of salt water.
8. Notify K.C.C. within 10 days when injection commences or terminates.

### A Regular Section of Land 1 Mile = 5,280 Ft.

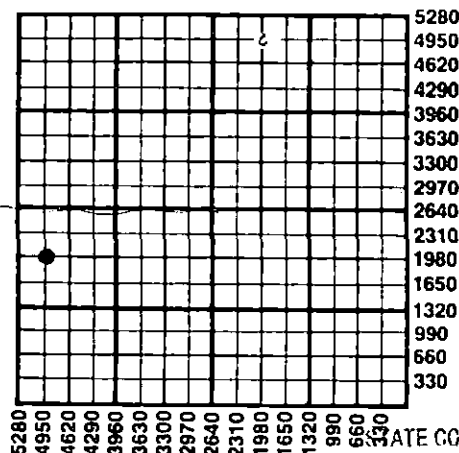

RECEIVED

OCT 3 1985  
10-3-85  
CONSERVATION DIVISION  
Wichita, Kansas

State Corporation Commission  
If an alternate 2 completion, cement in the production pipe from  
below any usable water to surface within 120 days of spud date.

State Corporation Commission of Kansas  
Conservation Division  
200 Colorado Derby Building  
Wichita, Kansas 67202  
(316) 263-3238