

CARD MUST BE TYPED

State of Kansas

CARD MUST BE SIGNED

## NOTICE OF INTENTION TO DRILL

(see rules on reverse side)

Expected Spud Date... December 18, 1987  
month day year

API Number 15-151-21,867-0000

East

OPERATOR: License # 3633 150'E-N/2. SW. NW. Sec. 35. Twp. 26. S, Rg. 12.  West

Name .MID. CONTINENT. DEVELOPMENT, INC. 3630 Ft. from South Line of Section

Address ..107. North Market. Suite. 1115. 4470 Ft. from East Line of Section

City/State/Zip ..Wichita, Kansas. 67202. (Note: Locate well on Section Plat on reverse side)

Contact Person.....Kent. Deutsch..... Nearest lease or unit boundary line 480 feet

Phone.....316/267-7551..... County.....Pratt.....

CONTRACTOR: License # 5929 Lease Name.....Mardis "F" Well # 1-35

Name ...DUKE DRILLING CO., INC. Ground surface elevation ..... feet MSL

City/State...Great Bend, Kansas 67530 Domestic well within 330 feet: \_\_\_yes  noWell Drilled For: Well Class: Type Equipment: Municipal well within one mile: \_\_\_yes  no Oil \_\_\_ Storage  Infield  Mud Rotary Depth to bottom of fresh water.....220.....

\_\_\_ Gas \_\_\_ Inj \_\_\_ Pool Ext. \_\_\_ Air Rotary Depth to bottom of usable water .....220.....

\_\_\_ OWWO \_\_\_ Expl \_\_\_ Wildcat \_\_\_ Cable Surface pipe by Alternate: 1  2 \_\_\_

If OWWO: old well info as follows: Surface pipe planned to be set .....300+.....

Operator ..... Conductor pipe required .....

Well Name ..... Projected Total Depth .....4300..... feet

Comp Date ..... Old Total Depth..... Formation.....Mississippian.....

I certify that well will comply with K.S.A. 55-101, et seq., plus eventually plugging hole to KCC specifications.

Date .December. 7, 1987 Signature of Operator or Agent *Kent Deutsch* Title.....AGENT.....

For KCC Use:


Conductor Pipe Required ..... feet; Minimum Surface Pipe Required .....240 feet per Alt. This Authorization Expires 6-7-88 Approved By *QWA* 12-7-87EFFECTIVE DATE: 12/12/87

Must be filed with the K.C.C. five (5) days prior to commencing well  
This card void if drilling not started within six (6) months of date received by K.C.C.

**Important procedures to follow:**

1. Notify District office before setting surface casing.
2. Set surface casing by circulating cement to the top.
3. File completion forms ACO-1 with K.C.C. within 120 days of well spud date, following instructions on ACO-1, side 1, and including copies of wireline logs.
4. Notify District office 48 hours prior to old well workover or re-entry.
5. Prior to filing Intent, prepare a proposed plugging plan in case well is D & A, then obtain approval of plan when calling district office prior to setting surface pipe.
6. Submit plugging report (CP-4) to K.C.C. after plugging is completed.
7. Obtain an approved injection docket number before disposing of salt water.
8. Notify K.C.C. within 10 days when injection commences or terminates.
9. If an alternate 2 completion, cement in the production pipe from below any usable water to surface within 120 days of spud date.

**A Regular Section of Land  
1 Mile = 5,280 Ft.**

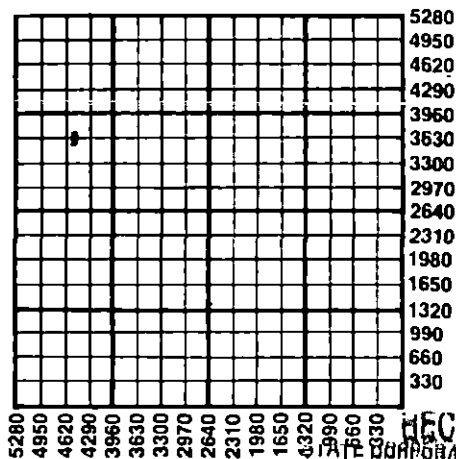

RECEIVED  
CORPORATION COMMISSION  
DEC 12-7-87  
1987  
CONSERVATION DIVISION  
Wichita, Kansas

State Corporation Commission of Kansas  
Conservation Division  
200 Colorado Derby Building  
Wichita, Kansas 67202-1212  
(316) 263-3238