

CARD MUST BE TYPED

State of Kansas

CARD MUST BE SIGNED

NOTICE OF INTENTION TO DRILL

(see rules on reverse side)

Expected Spud Date..... January 11, 1988
month day year

API Number 15- 151-21,874-0000

J
DA

OPERATOR: License # 9232
Name TIMBERLINE OIL & GAS CORPORATION
Address 105 East Eighth Street
City/State/Zip Pratt, Kansas 67124
Contact Person Brent C. Grote
Phone 316/672-9476

SE. SE. NE Sec. 34 Twp. 26 S, Rg. 12 X East West
..... 2970 Ft. from South Line of Section
..... 330 Ft. from East Line of Section

(Note: Locate well on Section Plat on reverse side)

CONTRACTOR: License # 5929
Name DUKE DRILLING CO., INC.
City/State Great Bend, Kansas 67530

Nearest lease or unit boundary line 330 feet
County Pratt
Lease Name Mardis Well # 1

Well Drilled For: Well Class: Type Equipment:
X Oil ___ Storage ___ Infield X Mud Rotary
___ Gas ___ Inj X Pool Ext. ___ Air Rotary
___ OWWO ___ Expl ___ Wildcat ___ Cable

Ground surface elevation 1875 [est.] feet MSL
Domestic well within 330 feet: ___ yes X no
Municipal well within one mile: ___ yes X no

If OWWO: old well info as follows:
Operator
Well Name
Comp Date Old Total Depth

Depth to bottom of fresh water 165
Depth to bottom of usable water 220
Surface pipe by Alternate: 1 X 2 ___
Surface pipe planned to be set 240
Conductor pipe required
Projected Total Depth 4350 feet
Formation Mississippian

I certify that well will comply with K.S.A. 55-101, et seq. plus eventually plugging hole to KCC specifications.
Date. 1/6/88 Signature of Operator or Agent Sally R. Byers Title. Agent

For KCC Use:
Conductor Pipe Required feet; Minimum Surface Pipe Required 240 feet per Alt. (1) X
This Authorization Expires 7-6-88 Approved By SA 1-6-88


EFFECTIVE DATE: 1-11-88

Must be filed with the K.C.C. five (5) days prior to commencing well
This card void if drilling not started within six (6) months of date received by K.C.C.

Important procedures to follow:

1. Notify District office before setting surface casing.
2. Set surface casing by circulating cement to the top.
3. File completion forms ACO-1 with K.C.C. within 120 days of well spud date, following instructions on ACO-1, side 1, and including copies of wireline logs.
4. Notify District office 48 hours prior to old well workover or re-entry.
5. Prior to filing Intent, prepare a proposed plugging plan in case well is D & A, then obtain approval of plan when calling district office prior to setting surface pipe.
6. Submit plugging report (CP-4) to K.C.C. after plugging is completed.
7. Obtain an approved injection docket number before disposing of salt water.
8. Notify K.C.C. within 10 days when injection commences or terminates.
9. If an alternate 2 completion, cement in the production pipe from below any usable water to surface within 120 days of spud date.

A Regular Section of Land 1 Mile = 5,280 Ft.

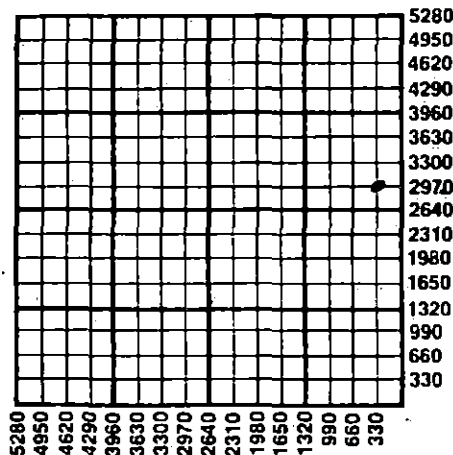

State Corporation Commission of Kansas
Conservation Division
200 Colorado Derby Building
Wichita, Kansas 67202-1212
(316) 263-3238

1-6-88
JAN 06 1988