

FOR KCC USE:

EFFECTIVE DATE: 3-22-92

DISTRICT # 1

SEA?  Yes  No

State of Kansas

NOTICE OF INTENTION TO DRILL

Must be approved by the K.C.C. five (5) days prior to commencing well

P.U.  
FORM C-1 7/91  
FORM MUST BE TYPED  
FORM MUST BE SIGNED  
ALL BLANKS MUST BE FILLED

Expected Spud Date March 21 1992  
month day year

Spot East  
NW NW NW Sec 9 Twp 26 S, Rg 11 XX West

OPERATOR: License # 30128  
Name: KENNETH S. WHITE  
Address: 200 E. First, Suite 210  
City/State/Zip: Wichita, Kansas 67202  
Contact Person: Kenneth S. White  
Phone: (316) 263-4007

4950 feet from South / XXXX line of Section  
4950 feet from East / XXXX line of Section  
IS SECTION XXX REGULAR IRREGULAR?

CONTRACTOR: License #: 5418  
Name: Allen Drilling Company

(NOTE: Locate well on the Section Plat on Reverse Side)  
County: Pratt  
Lease Name: Hunt Well #: 1  
Field Name: Stark East  
Is this a Prorated/Spaced Field? .... yes  no   
Target Formation(s): Mississippi  
Nearest Lease or unit boundary: 330'  
Ground Surface Elevation: 1849 feet MSL  
Water well within one-quarter mile: .... yes  no   
Public water supply well within one mile: .... yes  no   
Depth to bottom of fresh water: 100'  
Depth to bottom of usable water: 200'  
Surface Pipe by Alternate: XX 1 2  
Length of Surface Pipe Planned to be set: 250'  
Length of Conductor pipe required: none  
Projected Total Depth: 4200'  
Formation at Total Depth: Kinderhook  
Water Source for Drilling Operations:

Well Drilled For: Well Class: Type Equipment:  
XX Dil ... Enh Rec ... Infield XX Mud Rotary  
... Gas ... Storage XX Pool Ext. ... Air Rotary  
... OWWO ... Disposal ... Wildcat ... Cable  
... Seismic; ... # of Holes ... Other  
... Other

If OWWO: old well information as follows:  
Operator: .....  
Well Name: .....  
Comp. Date: ..... Old Total Depth .....

Length of Surface Pipe Planned to be set: 250'  
Length of Conductor pipe required: none  
Projected Total Depth: 4200'  
Formation at Total Depth: Kinderhook  
Water Source for Drilling Operations:  
XX well XXXX farm pond XXXX other  
DWR Permit #: not known at this time  
Will Cores Be Taken?: .... yes  no   
If yes, proposed zone: .....

Directional, Deviated or Horizontal wellbore? .... yes  no   
If yes, true vertical depth: .....  
Bottom Hole Location: .....

AFFIDAVIT

The undersigned hereby affirms that the drilling, completion and eventual plugging of this well will comply with K.S.A. 55-101, et. seq.  
It is agreed that the following minimum requirements will be met:

1. Notify the appropriate district office prior to spudding of well;
2. A copy of the approved notice of intent to drill shall be posted on each drilling rig;
3. The minimum amount of surface pipe as specified below shall be set by circulating cement to the top; in all cases surface pipe shall be set through all unconsolidated materials plus a minimum of 20 feet into the underlying formation;
4. If the well is dry hole, an agreement between the operator and the district office on plug length and placement is necessary prior to plugging;
5. The appropriate district office will be notified before well is either plugged or production casing is cemented in;
6. IF AN ALTERNATE II COMPLETION, PRODUCTION PIPE SHALL BE CEMENTED FROM BELOW ANY USABLE WATER TO SURFACE WITHIN 120 DAYS OF SPUD DATE. IN ALL CASES, NOTIFY DISTRICT OFFICE PRIOR TO ANY CEMENTING.

I hereby certify that the statements made herein are true and to the best of my knowledge and belief.

Date: 3/16/92 Signature of Operator or Agent: Kenneth S. White Title: Operator

FOR KCC USE:  
API # 15- 151-22,082-00-00  
Conductor pipe required None feet  
Minimum surface pipe required 220 feet per Alt (1)  
Approved by: MW 3-17-92  
This authorization expires: 9-17-92  
(This authorization void if drilling not started within 6 months of effective date.)  
Spud date: \_\_\_\_\_ Agent: \_\_\_\_\_

REMEMBER TO:

- File Drill Pit Application (form CDP-1) with Intent to Drill;
- File Completion Form ACO-1 within 120 days of spud date;
- File acreage attribution plat according to field proration orders;
- Notify appropriate district office 48 hours prior to workover or re-entry;
- Submit plugging report (CP-4) after plugging is completed;
- Obtain written approval before disposing or injecting salt water.

Mail to: Conservation Division, 200 Colorado Derby Building, 202 W. First St., Wichita, Kansas 67202-1286.

W  
A  
L  
K  
E  
R

RECEIVED  
KANSAS CORPORATION COMMISSION  
MAR 16 1992  
CONSERVATION DIVISION  
WICHITA, KS  
9  
26  
11W

IN ALL CASES PLOT THE INTENDED WELL ON THE PLAT BELOW

PLAT OF ACREAGE ATTRIBUTABLE TO A WELL IN A PRORATED OR SPACED FIELD

If the intended well is in a prorated or spaced field, please fully complete this side of the form. If the intended well is in a prorated or spaced field complete the plat below showing that the well will be properly located in relationship to other wells producing from the common source of supply. Please show all the wells within 1 mile of the boundaries of the proposed acreage attribution unit for gas wells and within 1/2 mile of the boundaries of the proposed acreage attribution unit for oil wells.

API NO. 15- \_\_\_\_\_  
 OPERATOR \_\_\_\_\_  
 LEASE \_\_\_\_\_  
 WELL NUMBER \_\_\_\_\_  
 FIELD \_\_\_\_\_

LOCATION OF WELL: COUNTY \_\_\_\_\_  
 \_\_\_\_\_ feet from south/north line of section  
 \_\_\_\_\_ feet from east/west line of section  
 SECTION \_\_\_\_\_ TWP \_\_\_\_\_ RG \_\_\_\_\_



NUMBER OF ACRES ATTRIBUTABLE TO WELL \_\_\_\_\_  
 QTR/QTR/QTR OF ACREAGE \_\_\_\_\_ - \_\_\_\_\_ - \_\_\_\_\_

IS SECTION \_\_\_\_\_ REGULAR or \_\_\_\_\_ IRREGULAR  
IF SECTION IS IRREGULAR, LOCATE WELL FROM NEAREST CORNER BOUNDARY.

Section corner used: \_\_\_\_\_ NE \_\_\_\_\_ NW \_\_\_\_\_ SE \_\_\_\_\_ SW

PLAT

(Show location of the well and shade attributable acreage for prorated or spaced wells.)  
 (Show footage to the nearest lease or unit boundary line.)

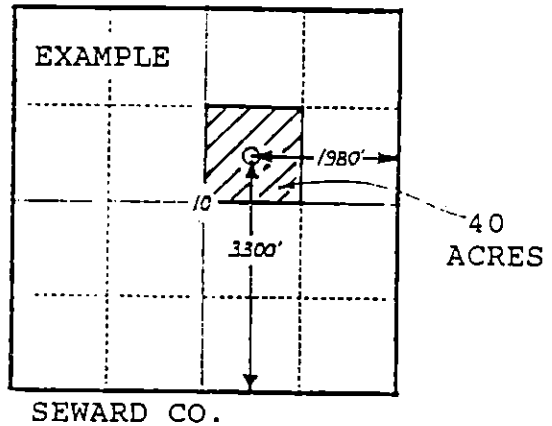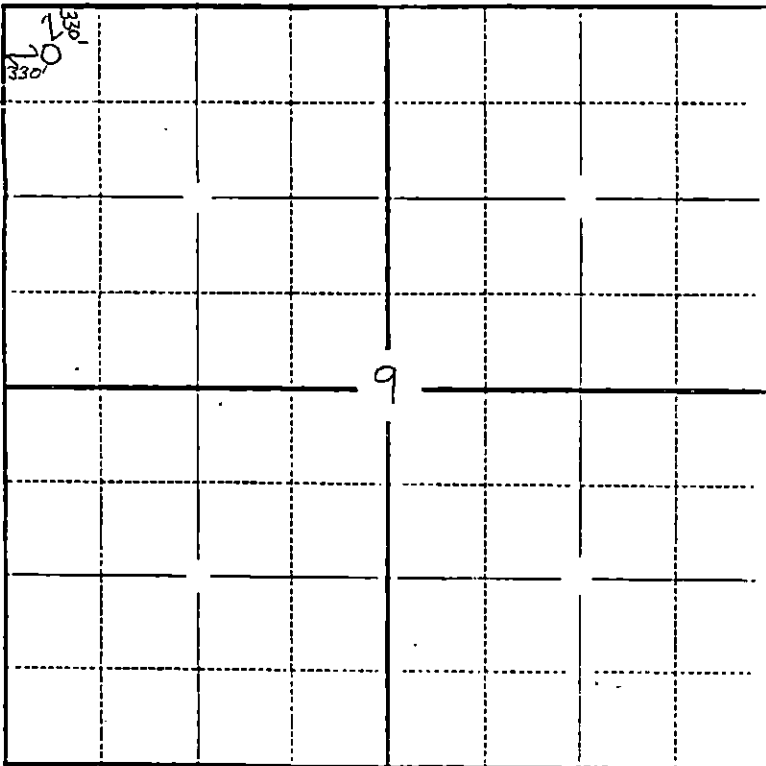

In plotting the proposed location of the well, you must show:

- 1) The manner in which you are using the depicted plat by identifying section lines, i.e. 1 section, 1 section with 8 surrounding sections, 4 sections, etc.;
- 2) the distance of the proposed drilling location from the section's south/north and east/west lines; and
- 3) the distance to the nearest lease or unit boundary line.