

NOTICE OF INTENTION TO DRILL

(see rules on reverse side)

Starting Date 12 5 85 month day year

API Number 15- 151-21,748-00-00

OPERATOR: License # 5313 Name F & M OIL CO., INC. Address 422 Union Center City/State/Zip Wichita, Kansas 67202 Contact Person Debra FitzGerald Phone (316)262-2636

NE SE SW Sec. 9 Twp. 26 S, Rg. 14W X West 990 Ft. from South Line of Section 2970 Ft. from East Line of Section

(Note: Locate well on Section Plat on reverse side)

CONTRACTOR: License # 5103 Name Union Drilling Co., Inc. City/State Wichita, Kansas 67202

Nearest lease or unit boundary line 990 feet County Pratt Lease Name Hutchins "B" Well # 1

Well Drilled For: Well Class: Type Equipment: XX Oil SWD Infield XX Mud Rotary Gas Inj Pool Ext. Air Rotary OWWO Expl Wildcat Cable

Ground surface elevation 2006 feet MSL Domestic well within 330 feet: yes X no Municipal well within one mile: yes X no Surface pipe by Alternate: 1 X 2 Depth to bottom of fresh water 190 257 Depth to bottom of usable water 300 Surface pipe planned to be set 400 Projected Total Depth 4550 feet Formation Arbuckle

If OWWO: old well info as follows: Operator Well Name Comp Date Old Total Depth

I certify that well will comply with K.S.A. 55-101, et seq., plus eventually plugging hole to KCC specifications.

cementing will be done immediately upon setting production casing. Date 11-26-85 Signature of Operator or Agent Debra FitzGerald Title Petroleum Geologist


For KCC Use: Conductor Pipe Required feet; Minimum Surface Pipe Required feet per Alt. 1 2 This Authorization Expires 5-27-86 Approved By 11-27-85

Must be filed with the K.C.C. five (5) days prior to commencing well
This card void if drilling not started within six (6) months of date received by K.C.C.

Important procedures to follow:

1. Notify District office before setting surface casing.
2. Set surface casing by circulating cement to the top.
3. File completion forms ACO-1 with K.C.C. within 90 days of well completion, following instructions on ACO-1, side 1, and including copies of wireline logs.
4. Notify District office 48 hours prior to old well workover or re-entry.
5. Prior to filing Intent, prepare a proposed plugging plan in case well is D & A, then obtain approval of plan when calling district office prior to setting surface pipe.
6. Submit plugging report (CP-4) to K.C.C. after plugging is completed.
7. Obtain an approved injection docket number before disposing of salt water.
8. Notify K.C.C. within 10 days when injection commences or terminates.
9. If an alternate 2 completion, cement in the production pipe from below any usable water to surface within 120 days of spud date.

A Regular Section of Land
1 Mile = 5,280 Ft.

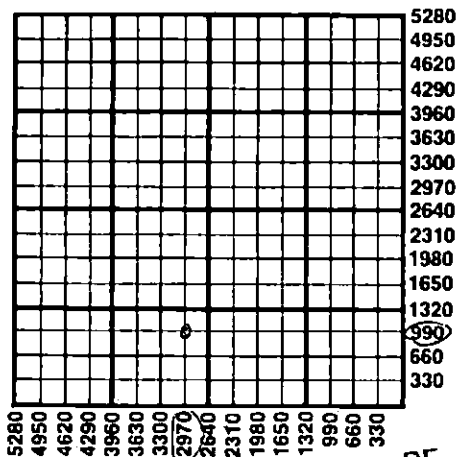

RECEIVED
STATE CORPORATION COMMISSION

NOV 27 1935

CONSERVATION DIVISION
Wichita, Kansas

State Corporation Commission of Kansas
Conservation Division
200 Colorado Derby Building
Wichita, Kansas 67202
(316) 263-3238