

CARD MUST BE TYPED

State of Kansas
NOTICE OF INTENTION TO DRILL

CARD MUST BE SIGNED

(see rules on reverse side)

Starting Date: 8 17 85
month day year

API Number 15- 151-21,667-0000

OPERATOR: License # 9232
Name Timberline Oil & Gas Corporation
Address 105 E. 8th Street
City/State/Zip Pratt, Kansas 67124
Contact Person Brant C. Grote or Roy Knappe, Jr.
Phone (316) 672-9476

SE SW NW ... Sec 29 Twp 26 S, Rge 12
(location) East West

2970 Ft North from Southeast Corner of Section
4290 Ft West from Southeast Corner of Section
(Note: Locate well on Section Plat on reverse side)

CONTRACTOR: License # 5428
Name Graves Drilling Co., Inc.
City/State Wichita, KS

Nearest lease or unit boundary line 330 feet.
County Pratt

Lease Name J. W. Hoeme Well# 6
Domestic well within 330 feet: yes no
Municipal well within one mile: yes no

Well Drilled For: Well Class: Type Equipment:
 Oil Swd Infield Mud Rotary
 Gas Inj Pool Ext. Air Rotary
 OWWO Expl Wildcat Cable

Depth to Bottom of fresh water 240 feet
Lowest usable water formation Nippewalla Group-L. Permian

Depth to Bottom of usable water 260 feet
Surface pipe by Alternate: 1 2
Surface pipe to be set 300 feet
Conductor pipe if any required NA feet
Ground surface elevation 1919 feet MSL

If OWWO: old well info as follows:
Operator
Well Name
Comp Date Old Total Depth
Projected Total Depth 4500 feet
Projected Formation at TD Arbuckle
Expected Producing Formations Arbuckle

This Authorization Expires 1-31-86
Approved By 7-31-85 [Signature] R


I certify that we will comply with K.S.A. 55-101, et seq., plus eventually plugging hole to K.C.C. specifications.

RC H for KDHE

Date 7/30/85 Signature of Operator or Agent [Signature] Title Vice President

Must be filed with the K.C.C. five (5) days prior to commencing well
 This card void if drilling not started within six (6) months of date received by K.C.C.

A Regular Section of Land
 1 Mile = 5,280 Ft.

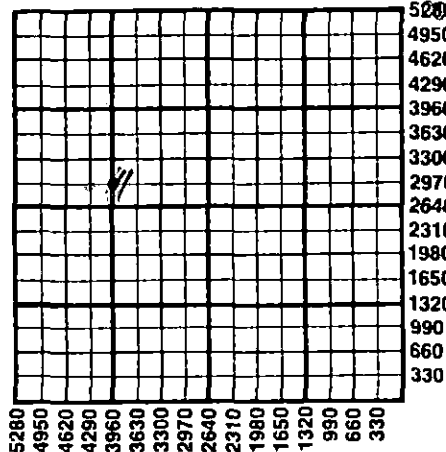

RECEIVED
 STATE CORPORATION COMMISSION
 JUL 31 1985
 7-31-85
 CONSERVATION DIVISION
 Wichita, Kansas

Important procedures to follow :

1. Notify District office before setting surface casing.
2. Set surface casing by circulating cement to the top.
3. File completion forms ACO-1 with K.C.C. within 90 days of well completion, following instructions on ACO-1, side 1, and including copies of wireline logs.
4. Notify District office 48 hours prior to old well workover or re-entry.
5. Prior to plugging, prepare a plugging plan, then obtain agreement from the appropriate district office for an approved plugging plan.
6. Submit plugging report (CP-4) to K.C.C. after plugging is completed.
7. Obtain an approved injection docket number before disposing of salt water.
8. Notify K.C.C. within 10 days when injection commences or terminates.
9. If an alternate 2 completion, cement in the production pipe from below any usable water to surface within 120 days of spud date.

State Corporation Commission of Kansas
Conservation Division
 200 Colorado Derby Building
 Wichita, Kansas 67202
 (316) 263-3238