

NOTICE OF INTENTION TO DRILL

(see rules on reverse side)

Starting Date 12 - 10 - 85 month day year

API Number 15- 151-21,735-00-00

OPERATOR: License # 5364

N/2 NW NW Sec. 18. Twp. 26 S, Rg. 15 X West

Name Beren Corp

Address 970 Fourth Financial Center

City/State/Zip Wichita, KS 67202

Contact Person Don Beauchamp

Phone (316)265-3311

4950 Ft. from South Line of Section

4620 Ft. from East Line of Section

(Note: Locate well on Section Plat on reverse side)

CONTRACTOR: License # 5147

Nearest lease or unit boundary line 330 feet

County Pratt

Lease Name Wood Well # 3

Ground surface elevation 2055 feet MSL

Domestic well within 330 feet: yes X no

Municipal well within one mile: yes X no

Surface pipe by Alternate: 1 X 2

Depth to bottom of fresh water 177

Depth to bottom of usable water 348

Surface pipe planned to be set 400

Projected Total Depth 4250 feet

Formation Base Kansas City

Well Drilled For: Well Class: Type Equipment:

X Oil SWD Infield X Mud Rotary

X Gas Inj X Pool Ext. Air Rotary

OWWO Expl Wildcat Cable

If OWWO: old well info as follows:

Operator

Well Name

Comp Date Old Total Depth

I certify that well will comply with K.S.A. 55-101, et seq., plus eventually plugging hole to KCC specifications.

REN/KDHE

cementing will be done immediately upon setting production casing

Date 10/22/85 Signature of Operator or Agent Don W. Beauchamp Title Geologist

For KCC Use:

Conductor Pipe Required feet; Minimum Surface Pipe Required feet per Alt. 1 2


This Authorization Expires 4-24-86 Approved By 10-24-85

Must be filed with the K.C.C. five (5) days prior to commencing well  
This card void if drilling not started within six (6) months of date received by K.C.C.

**Important procedures to follow:**

1. Notify District office before setting surface casing.
2. Set surface casing by circulating cement to the top.
3. File completion forms ACO-1 with K.C.C. within 90 days of well completion, following instructions on ACO-1, side I, and including copies of wireline logs.
4. Notify District office 48 hours prior to old well workover or re-entry.
5. Prior to filing Intent, prepare a proposed plugging plan in case well is D & A, then obtain approval of plan when calling district office prior to setting surface pipe.
6. Submit plugging report (CP-4) to K.C.C. after plugging is completed.
7. Obtain an approved injection docket number before disposing of salt water.
8. Notify K.C.C. within 10 days when injection commences or terminates.

**A Regular Section of Land**  
1 Mile = 5,280 Ft.

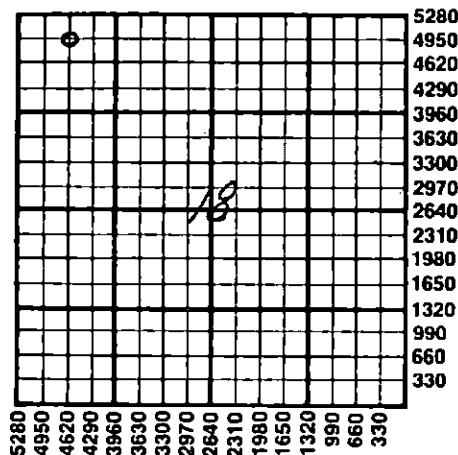

**RECEIVED** If an alternate 2 completion, cement in the production pipe from  
STATE CORPORATION COMMISSION only usable water to surface within 120 days of spud date.

**OCT 24 1985**

CONSERVATION DIVISION  
Wichita, Kansas

State Corporation Commission of Kansas  
Conservation Division  
200 Colorado Derby Building  
Wichita, Kansas 67202  
(316) 263-3238