

CARD MUST BE TYPED

State of Kansas
NOTICE OF INTENTION TO DRILL
(see rules on reverse side)

CARD MUST BE SIGNED

Starting Date: Oct. 10, 1984
month day year

API Number 15- 151-21,481-00-00

OPERATOR: License # 5141
Name ZENITH DRILLING CORPORATION
Address Suite 505 Fourth Financial Center
City/State/Zip Wichita, Kansas 67202
Contact Person Sherrill Compton
Phone (316) 265-6697

..... NW NW Sec .35. Twp .26. S, Rge .15. East
(location) West
4620 Ft North from Southeast Corner of Section
4620 Ft West from Southeast Corner of Section
(Note: Locate well on Section Plat on reverse side)

~~CONTRACTOR:~~ License # 5142
Name Sterling Drilling Co.
City/State Sterling, Ks. 67579

Nearest lease or unit boundary line 660 feet.
County Pratt
Lease Name Kell Well# 1
Domestic well within 330 feet: yes no
Municipal well within one mile: yes no

Well Drilled For: Well Class: Type Equipment:
 Oil Swd Infield Mud Rotary
 Gas Inf Pool Ext. Air Rotary
 OWWO Expl Wildcat Cable

Depth to Bottom of fresh water 350 feet
Lowest usable water formation
Depth to Bottom of usable water 350 feet
Surface pipe by Alternate: 1 2
Surface pipe to be set 400 feet
Conductor pipe if any required None feet
Ground surface elevation approx. 2040 feet MSL
This Authorization Expires 3-18-85
Approved By 9-18-84 K

If OWWO: old well info as follows:

Operator
Well Name
Comp Date Old Total Depth
Projected Total Depth 4550 feet
Projected Formation at TD Viola
Expected Producing Formations Kinderhook Sand


I certify that we will comply with K.S.A. 55-101, et seq., plus eventually plugging hole to K.C.C. specifications.

Date 9/17/84 Signature of Operator or Agent Sherrill Compton Title Vice-President
Sherrill Compton

mhc/KOME 9/18/84

Must be filed with the K.C.C. five (5) days prior to commencing well
This card void if drilling not started within six (6) months of date received by K.C.C.

A Regular Section of Land
1 Mile = 5,280 Ft.

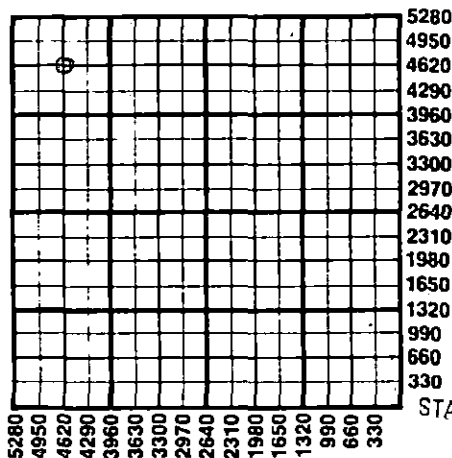

Important procedures to follow :

1. Notify District office before setting surface casing.
2. Set surface casing by circulating cement to the top.
3. File completion forms ACO-1 with K.C.C. within 90 days of well completion, following instructions on ACO-1, side I, and including copies of wireline logs.
4. Notify District office 48 hours prior to old well workover or re-entry.
5. Prior to plugging, prepare a plugging plan, then obtain agreement from the appropriate district office for an approved plugging plan.
6. Submit plugging report (CP-4) to K.C.C. after plugging is completed.
7. Obtain an approved injection docket number before disposing of salt water.
8. Notify K.C.C. within 10 days when injection commences or terminates.
9. If an alternate 2 completion, cement in the production pipe from below any usable water to surface within 120 days of spud date.

RECEIVED
STATE CORPORATION COMMISSION

SEP 18 1984

CONSERVATION DIVISION
Wichita, Kansas

State Corporation Commission of Kansas
Conservation Division
200 Colorado Derby Building
Wichita, Kansas 67202
(316) 263-3238