

CORRECTED

CORRECTED LOCATION

For KCC Use: 6-24-03
Effective Date:
District #
SGA? Yes No

KANSAS CORPORATION COMMISSION
OIL & GAS CONSERVATION DIVISION
NOTICE OF INTENT TO DRILL

RECEIVED
7-25-03
JUL 25 2003

Form C-1
December 2002
Form must be Typed
Form must be Signed
All blanks must be Filled

Must be approved by KCC five (5) days prior to commencing well

Ap 105' N 1/4 of KCC WICHITA

Expected Spud Date 7 10 2003
month day year

OPERATOR: License# 5363
Name: BEREXCO, INC.
Address: P O BOX 20380
City/State/Zip: WICHITA, KS 67208
Contact Person: GARY MISAK
Phone: 316-265-3311

CONTRACTOR: License# 5929
Name: DUKE DRILLING

Well Drilled For: Oil, Gas, OWO, Seismic, Other
Well Class: Enh Rec, Storage, Disposal, Other
Type Equipment: Infield, Mud Rotary, Air Rotary, Cable

If OWWO: old well information as follows:
Operator:
Well Name:
Original Completion Date: Original Total Depth:

Directional, Deviated or Horizontal wellbore? Yes No
If Yes, true vertical depth:
Bottom Hole Location:
KCC DKT #:

* WAS: 990' FSL/FEL IS: 1095' FS4/FEL

Spot NW SE SE Sec. 32 Twp. 34 S. R. 14
1095 feet from N / S Line of Section
1055 feet from E / W Line of Section
Is SECTION Regular Irregular?

(Note: Locate well on the Section Plat on reverse side)

County: BARBER
Lease Name: FARLEY Well #: 6
Field Name: AETNA
Is this a Prorated / Spaced Field? Yes No
Target Information(s): MISSISSIPPI
Nearest Lease or unit boundary: 1055
Ground Surface Elevation: 1496 feet MSL
Water well within one-quarter mile: Yes No
Public water supply well within one mile: Yes No
Depth to bottom of fresh water: 150
Depth to bottom of usable water: 180
Surface Pipe by Alternate: 1 2
Length of Surface Pipe Planned to be set: 900
Length of Conductor Pipe required: NONE
Projected Total Depth: 5000
Formation at Total Depth: MISSISSIPPI
Water Source for Drilling Operations: Well Farm Pond Other X
DWR Permit #:
Will Cores be taken? Yes No
If Yes, proposed zone:

AFFIDAVIT

The undersigned hereby affirms that the drilling, completion and eventual plugging of this well will comply with K.S.A. 55 et. seq.

It is agreed that the following minimum requirements will be met:

- 1. Notify the appropriate district office prior to spudding of well;
2. A copy of the approved notice of intent to drill shall be posted on each drilling rig;
3. The minimum amount of surface pipe as specified below shall be set by circulating cement to the top; in all cases surface pipe shall be set through all unconsolidated materials plus a minimum of 20 feet into the underlying formation.
4. If the well is dry hole, an agreement between the operator and the district office on plug length and placement is necessary prior to plugging;
5. The appropriate district office will be notified before well is either plugged or production casing is cemented in;
6. If an ALTERNATE II COMPLETION, production pipe shall be cemented from below any usable water to surface within 120 days of spud date. Or pursuant to Appendix "B" - Eastern Kansas surface casing order #133,891-C, which applies to the KCC District 3 area, alternate II cementing must be completed within 30 days of the spud date or the well shall be plugged. In all cases, NOTIFY district office prior to any cementing.

I hereby certify that the statements made herein are true and to the best of my knowledge and belief.

Date: 7/17/2003 Signature of Operator or Agent: Gary Misak Title: DIVISION ENGINEER

For KCC Use ONLY
API # 15 - 007.22749.00-00
Conductor pipe required None feet
Minimum surface pipe required 200 feet per Alt 1
Approved by: RSP 6.19.03 / RSP 7.25.03
This authorization expires: 12.19.03
(This authorization void if drilling not started within 6 months of effective date.)
Spud date: Agent:

Remember to:

- File Drill Pit Application (form CDP-1) with Intent to Drill;
- File Completion Form ACO-1 within 120 days of spud date;
- File acreage attribution plat according to field proration orders;
- Notify appropriate district office 48 hours prior to workover or re-entry;
- Submit plugging report (CP-4) after plugging is completed;
- Obtain written approval before disposing or injecting salt water.
- If this permit has expired (See: authorized expiration date) please check the box below and return to the address below.
Well Not Drilled - Permit Expired
Signature of Operator or Agent:
Date:

32 34 14

RECEIVED

JUL 25 2003

KCC WICHITA

IN ALL CASES PLOT THE INTENDED WELL ON THE PLAT BELOW

Plat of acreage attributable to a well in a prorated or spaced field

If the intended well is in a prorated or spaced field, please fully complete this side of the form. If the intended well is in a prorated or spaced field complete the plat below showing that the well will be properly located in relationship to other wells producing from the common source of supply. Please show all the wells and within 1 mile of the boundaries of the proposed acreage attribution unit for gas wells and within 1/2 mile of the boundaries of the proposed acreage attribution unit for oil wells.

API No. 15 - 00722749
Operator: BEREXCO, INC.
Lease: FARLEY
Well Number: 6
Field: AETNA

Location of Well: County: BARBER
1095 feet from N / S Line of Section
1055 feet from E / W Line of Section
Sec. 32 Twp. 34 S. R. 14 East West

Number of Acres attributable to well: _____
QTR / QTR / QTR of acreage: NW - SE - SE

Is Section: Regular or Irregular



If Section is Irregular, locate well from nearest corner boundary.

Section corner used: NE NW SE SW

PLAT

(Show location of the well and shade attributable acreage for prorated or spaced wells.)

(Show footage to the nearest lease or unit boundary line.)

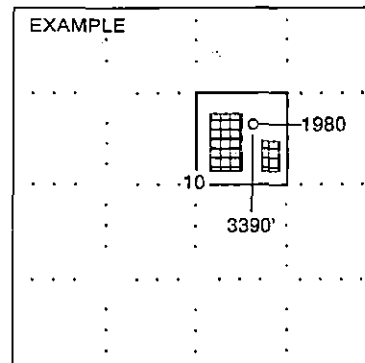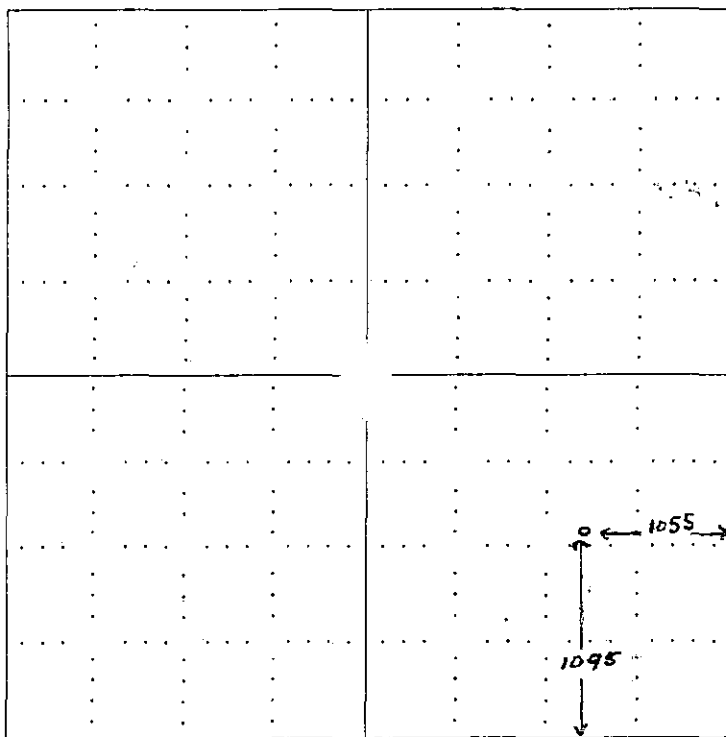

NOTE: In all cases locate the spot of the proposed drilling locaton.

In plotting the proposed location of the well, you must show:

1. The manner in which you are using the depicted plat by identifying section lines, i.e. 1 section, 1 section with 8 surrounding sections, 4 sections, etc.
2. The distance of the proposed drilling location from the section's south / north and east / west.
3. The distance to the nearest lease or unit boundary line.
4. If proposed location is located within a prorated or spaced field a certificate of acreage attribution plat must be attached: (CO-7 for oil wells; CG-8 for gas wells).