

STATE OF KANSAS
STATE CORPORATION COMMISSION

Form CP-4


Give All Information Completely
Make Required Affidavit
Mail or Deliver Report to:
Conservation Division
State Corporation Commission

WELL PLUGGING RECORD

P. O. Box 17027
Wichita, Kansas 67217
NORTH

Barber County, Sec. 5 Twp. 35 Rge. (E) 14 (W)

Location as "NE/CNW/SW" or footage from lines: App. C SW NW
Lease Owner K & E Drilling, Inc., Westmore Drilling Co., Inc. et al
Lease Name Farley-MacGregor "A" Well No. 2-5
Office Address 816 Union Center Bldg., Wichita, KS 67202
Character of Well (completed as Oil, Gas or Dry Hole) Gas
Date well completed June 5 1965
Application for plugging filed March 29 1978
Application for plugging approved March 31 1978
Plugging commenced May 17 1978
Plugging completed June 13 1978
Reason for abandonment of well or producing formation Depletion

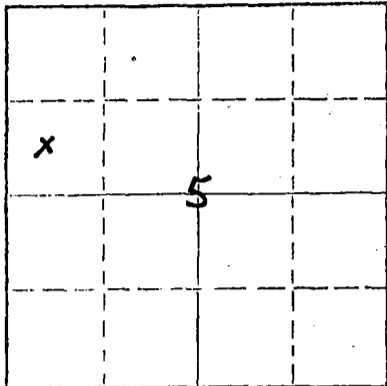

Locate well correctly on above
Section Plat

If a producing well is abandoned, date of last production December 1977

Was permission obtained from the Conservation Division or its agents before plugging was commenced? Yes

Name of Conservation Agent who supervised plugging of this well William T. Owen
Producing formation Mississippian Depth to top 4886' Bottom 4918' Total Depth of Well 4990 Feet
Show depth and thickness of all water, oil and gas formations.

OIL, GAS OR WATER RECORDS

CASING RECORD

FORMATION	CONTENT	FROM	TO	SIZE	PUT IN	PULLED OUT
				8-5/8"	869'	None
				4-1/2"	4987'	None

Describe in detail the manner in which the well was plugged, indicating where the mud fluid was placed and the method or methods used in introducing it into the hole. If cement or other plugs were used, state the character of same and depth placed, from _____ feet to _____ feet for each plug set.

Mixed 225 sx. Common cement, 3 sx. hulls and 10 sx. gel and pumped same down 4-1/2" casing. Calculated cement plug inside of 4-1/2" casing from 2340' to 4946' (old plug back T.D.) Pumped 11 cubic yards of redi-mix down 4-1/2" casing filling same to bottom of cellar. Put 2' of cement in cellar covering top of cut off 4-1/2" casing.

RECEIVED
STATE CORPORATION COMMISSION
JUL 06 1978
7-6-78
CONSERVATION DIVISION
Wichita, Kansas

(If additional description is necessary, use BACK of this sheet)
Name of Plugging Contractor No casing pulled; cementing done by Allied Cementing Co., Inc. and
Address Medicine Lodge Redi-Mix, Inc.

STATE OF KANSAS, COUNTY OF SEDGWICK, ss.

Wayne L. Brinegar (employee of owner) or (owner or operator) of the above-described well, being first duly sworn on oath, says: That I have knowledge of the facts, statements, and matters herein contained and the log of the above-described well as filed and that the same are true and correct. So help me God.

(Signature) Wayne L. Brinegar
816 Union Center Bldg., Wichita, KS 67202
(Address)

Subscribed and sworn to before me this 5th day of July, 1978

April 8, 1982

Nancy E. Haner
Nancy E. Haner
Notary Public.



DRILLER'S WELL LOG

OPERATOR: K & E Drilling, Inc.

WELL NAME: Farley-MacGregor #2-5

LOCATION: 590' W; 600' N, C W/2
Sec. 5-35S-14W
Barber County, Kansas

CONTRACTOR: **K & E DRILLING, INC.**
719 UNION CENTER BLDG.
WICHITA, KANSAS

COMMENCED: May 7, 1965

CASING RECORD: 8-5/8" @ 869'
4-1/2" @ 4987'

COMPLETED: May 20, 1965

ELEVATION: 1583' DF; 1586' KB

ROTARY TOTAL DEPTH: 4990'

PRODUCTION:

FORMATION RECORD

Depths shown indicate bottom of formations encountered.

Soil & Sand	105
Sand & Clay	190
Red Bed	670
Shale & Shells	2120
Lime	3005
Shale & Lime	3200
Lime	3834
Sand & Lime	3989
Lime	4175
Shale & Sand	4226
Lime	4434
Lime & Chert	4480
Lime	4990

RECEIVED
STATE CORPORATION COMMISSION
MAR 31 1978
3-31-78
CONSERVATION DIVISION
Wichita, Kansas

CERTIFICATION

State of KANSAS }
County of SEDGWICK } ss:

I, H. L. Wilson, of K&E DRILLING, INC., upon oath state that the above and foregoing is a true and correct copy of the Driller's Log of the above named well.

H. L. Wilson
H. L. Wilson

Subscribed and sworn to before me this 27th day of May, 19 65

James L. Downing
James L. Downing Notary Public.

My Commission expires: 8-5-67

