


Give All Information Completely  
Make Required Affidavit  
Mail or Deliver Report to:  
Conservation Division  
State Corporation Commission  
800 Biting Building  
Wichita, Kansas

WELL PLUGGING RECORD  
OR  
FORMATION PLUGGING RECORD

15-151-10272-0000

Strike out upper line  
when reporting plugging  
off formations.

NORTH

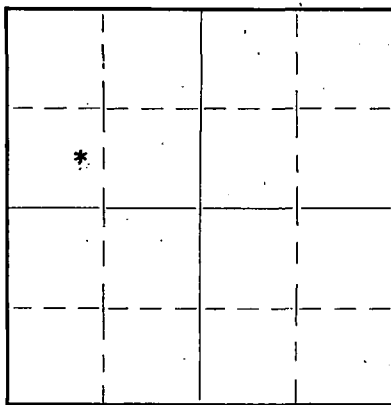

Locate well correctly on above  
Section Plat

Pratt County, Sec. 1 Twp. 27 Rge. (E) 13 (W)  
Location as "NE $\frac{1}{4}$ NW $\frac{1}{4}$ SW $\frac{1}{4}$ " or footage from lines E/2 SW/4 NW/4  
Lease Owner Tuesday Oil Company  
Lease Name Jackson Well No. 2  
Office Address Union National Bank Bldg., Wichita, Kansas.  
Character of Well (Completed as Oil, Gas or Dry Hole) Dry Hole.  
Date, well completed June 20, 1941.  
Application for plugging filed July 17, 1941.  
Application for plugging approved July 17, 1941.  
Plugging Commenced July 26, 1941.  
Plugging Completed July 26, 1941.  
Reason for abandonment of well or producing formation Dry Hole.

If a producing well is abandoned, date of last production 193...  
Was permission obtained from the Conservation Division or its agents before plugging was commenced? Yes

Name of Conservation Agent who supervised plugging of this well T. C. Alexander  
Producing formation Depth to top Bottom Total Depth of Well 4289 Feet.  
Show depth and thickness of all water, oil and gas formations.


OIL, GAS OR WATER RECORDS

CASING RECORD

Formation	Content	From	To	Size	Put In	Pulled Out
				10-3/4"	410'	None
				7"	4216'	2623

Describe in detail the manner in which the well was plugged, indicating where the mud fluid was placed and the method or methods used in introducing it into the hole. If cement or other plugs were used, state the character of same and depth placed, from...feet to...feet for each plug set.

7" Casing set at 4216', cemented with 100 sacks.  
10-3/4" Casing set at 410', cemented.  
Mud to 4216' - bridged - 4 sacks cement.  
Mud to 410' - bridged - 10 sacks cement to 390'.  
Mud to 25' - bridged - 6 sacks cement to cellar base.

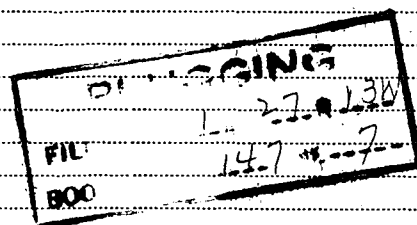

(If additional description is necessary, use BACK of this sheet)

Correspondence regarding this well should be addressed to Tuesday Oil Company  
Address Union National Bank Bldg., Wichita, Kansas.

STATE OF KANSAS, COUNTY OF SEDGWICK, ss.  
Heber Beardmore, Jr. (employee of owner) or (owner or operator) of the above-described well,  
being first duly sworn on oath, says: That I have knowledge of the facts, statements, and matters herein contained and the log of the above-described well as filed and that the same are true and correct. So help me God

(Signature) Heber Beardmore, Jr.  
606 Ellis-Singleton Bldg., Wichita, Kansas.  
(Address)

SUBSCRIBED AND SWORN to before me this 31st day of July

My commission expires December 6, 1943.

Jane E. Macaulay  
Notary Public.

Jackson No. 2 Well

E/2 SW/4 NW/4 Section 1-27S-13W,  
Pratt County, Kansas.

Drilled for: Tuesday Oil Company  
Drilled by: Beardmore Drilling Company, Inc.

<u>FORMATION</u>	<u>DEPTH</u>
surface	400
red bed & shale	835
red rock, shale & shells	1290
shale, shells & salt	1550
shale & shells	1825
shale & lime	1905
lime	2010
shale & lime	2565
shale	2680
shale & shells	2945
shale	2970
lime	3010
shale & lime	3140
shale	3225
sandy lime	3265
shale	3325
broken lime	3425
lime	3575
broken lime	3670
lime & shale	3830
lime	4035
shale	4085
shale & chert	4115
lime & chert	4140
lime	4145
lime & chert	4190
chert	4199
simpson shale	4216
chert & lime	4275
salt water	4289 T.D.

**PLUGGING**  
FILE NO. L-27-13E  
BOOK PAGE 47 LINE 7

