


Give All Information Completely
Make Required Affidavit
Mail or Deliver Report to:
Conservation Division
State Corporation Commission
211 No. Broadway
Wichita, Kansas

15-051-30222-0000 Form CP-4
WELL PLUGGING RECORD

Ellis County, Sec. 29 Twp. 15S Rge. (E)20 (W)

Location as "NE/CNW/SW" or footage from lines C SE SE SE
Lease Owner Rains & Williamson Oil Co.
Lease Name FRED BULLOCK Well No. 1
Office Address 1425 Wichita Plaza, Wichita, Kansas
Character of Well (completed as Oil, Gas or Dry Hole) Dry Hole
Date well completed September 19 1965
Application for plugging filed September 19 1965
Application for plugging approved September 19 1965
Plugging commenced September 19 1965
Plugging completed September 19 1965
Reason for abandonment of well or producing formation No oil or gas found in commercial quantities.
If a producing well is abandoned, date of last production -- 19
Was permission obtained from the Conservation Division or its agents before plugging was commenced? Yes

NORTH

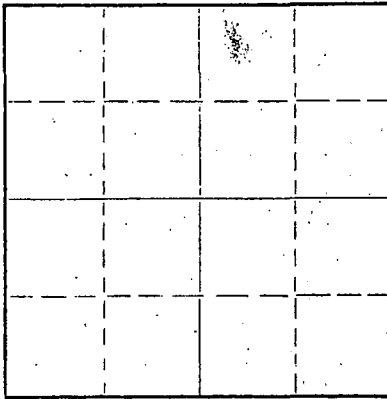

Locate well correctly on above Section Plat

Name of Conservation Agent who supervised plugging of this well Eldon Petty, Hays, Kansas
Producing formation _____ Depth to top _____ Bottom _____ Total Depth of Well 4010 Feet
Show depth and thickness of all water, oil and gas formations.

OIL, GAS OR WATER RECORDS

CASING RECORD

FORMATION	CONTENT	FROM	TO	SIZE	PUT IN	PULLED OUT
				8-5/8"	220.35'	None

Describe in detail the manner in which the well was plugged, indicating where the mud fluid was placed and the method or methods used in introducing it into the hole. If cement or other plugs were used, state the character of same and depth placed, from _____ feet to _____ feet for each plug set.

Set plug @ 540', spotted with 25 sacks cement, mud back to 240', plug and hulls to 240', spotted with 25 sacks cement, mud back to 40', set solid bridge with plug and hulls, capped with 10 sacks cement. Plugging completed 8:20 a.m. 9-19-65.

RECEIVED
STATE CORPORATION COMMISSION
SEP 24 1965
CONSERVATION DIVISION
Wichita, Kansas

(If additional description is necessary, use BACK of this sheet)

Name of Plugging Contractor Rains & Williamson Oil Co.
Address 1425 Wichita Plaza, Wichita, Kansas

STATE OF KANSAS, COUNTY OF SEDGWICK, ss.
Wilson Rains ~~employee or owner~~ (owner or operator) of the above-described well, being first duly sworn on oath, says: That I have knowledge of the facts, statements, and matters herein contained and the log of the above-described well as filed and that the same are true and correct. So help me God.
(Signature) Wilson Rains
1425 Wichita Plaza, Wichita, Kansas
(Address)

SUBSCRIBED AND SWORN to before me this 23rd day of September, 1965

My commission expires January 8, 1968
Shirley Keck
Shirley Keck Notary Public.

ROTARY DRILLING LOG

OPERATOR: Rains & Williamson Oil Co.
#1 Fred Bullock
C SE SE SE Section 29-15S-20W
Ellis County, Kansas

CONTRACTOR: Rains & Williamson
Oil Co.
COMMENCED: 9-10-65
COMPLETED: 9-19-65
REMARKS: Set 220.35' of 8-5/8"
Surface Casing with
150 sacks GL3 cement.

FORMATIONS:

Clay & Rocke	40'
Shale	1000'
Sand	1206'
Shale	1527'
Anhydrite	1570'
Shale & Shells	2155'
Lime & Shale	2680'
Shale & Lime	3400'
Lime	3485'
Lime & Shale	3625'
Lime	4010'
RTD (D&A)	4010'

RECEIVED
STATE CORPORATION COMMISSION

SEP 24 1965

CONSERVATION DIVISION
Wichita, Kansas

We certify the above log is true
and correct to the best of our
knowledge and belief.

RAINS & WILLIAMSON OIL CO.


Wilson Rains, Partner

Subscribed and sworn to before me, a Notary Public indand for the State
of Kansas, County of Sedgwick, this 23rd day of September, 1965.

My Commission Expires:
January 8, 1968


Shirley Keck, Notary Public