

STATE OF KANSAS
STATE CORPORATION COMMISSION
200 Colorado Derby Building
Wichita, Kansas 67202

WELL PLUGGING RECORD
K.A.R.-82-3-117

15-051-20682-0000
API NUMBER 15-D-15,921

LEASE NAME Fischer

WELL NUMBER A-2

330 Ft. from S Section Line

4920 Ft. from E Section Line

SEC. 8 TWP. 11 RGE. 20 (E) or (W)

COUNTY Ellis

Date Well Completed 5-29-1990

Plugging Commenced 3:00 PM

Plugging Completed 4:00PM 5-29-90

TYPE OR PRINT
NOTICE: Fill out completely
and return to Cons. Div.
office within 30 days.

LEASE OPERATOR Elada Oil Co.

ADDRESS P.O. Box 7; Palco, Kansas, 67657

PHONE# (913) 737-5615 OPERATORS LICENSE NO. 3474

Character of Well Oil

(Oil, Gas, D&A, SWD, Input, Water Supply Well)

The plugging proposal was approved on May 5, 1990 (date)

by Dennis L. Hamel (KCC District Agent's Name).

Is ACO-1 filed? N.R. If not, is well log attached? Drilled Dec. 1970

Producing Formation K.C.F. Depth to Top 335 1/4 Bottom 351 1/4 T.D. 3732

Show depth and thickness of all water, oil and gas formations.

OIL, GAS OR WATER RECORDS

CASING RECORD

Formation	Content	From	To	Size	Put in	Pulled out
K.C.	Casing	TD	Top	5 1/2	0	0
K.C.	Casing			8 5/8		0

Describe in detail the manner in which the well was plugged, indicating where the mud fluid was placed and the method or methods used in introducing it into the hole. If cement or other plugs were used, state the character of same and depth placed, from feet to feet each set.
Pumped in 5 1/2 casing w/65 sks cement w/3/4 f.c. plus pumped in add 250 sks cement w/3/4 f.c. and 4 sks hulls mixed in cement. Max 750# S.I. 500#. Pumped in 8 5/8" casing w/75 sks cement w/3/4 f.c. and 1 sks Hulls mixed in cement. Max 500# S.I. 300#.

(If additional description is necessary, use BACK of this form.)

Name of Plugging Contractor Allied Cement License No. _____

Address Plainville, Kansas, 67663

NAME OF PARTY RESPONSIBLE FOR PLUGGING FEES: Truman Meyer

STATE OF Kansas COUNTY OF Rooks, ss. 511-18-3089

(Employee of Operator) or (Operator) of above-described well, being first duly sworn on oath, says: That I have knowledge of the facts, statements, and matters herein contained and the log of the above-described well as filed that the same are true and correct, so help me God.

(Signature) Truman Meyer

(Address) Box 7 - Palco, Kans. 67657

before me this 20th day of June, 19 90

Leo J. Von Feldt
Notary Public




RECEIVED
STATE CORPORATION COMMISSION
JUN 21 1990
My Commission Expires Oct 3, 1991
CONSERVATION DIVISION
Wichita, Kansas

STATE OF KANSAS
STATE CORPORATION COMMISSION
CONSERVATION DIVISION
P. O. BOX 17027
WICHITA, KANSAS 67217

FORM CP-4

WELL PLUGGING RECORD

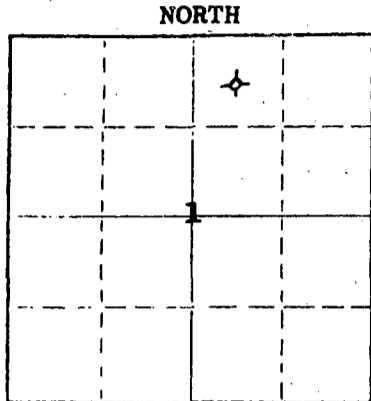

Locate well correctly on above Section Plot

Pratt County, Sec 1 Twp 27S Rge 12W (NW) (W)
Location as "NE/CNW/SE/SW" or footage from lines: C NW NE
Lease Owner Hummon Oil Company
Lease Name Glenn Fisher Well No. 1
Office Address 1725 Vickers-KSB&T Bldg, Wichita, Kansas
Character of Well (completed as Oil, Gas or Dry Hole) Dry Hole
Date well completed August 14, 1977
Application for plugging filed August 14, 1977
Application for plugging approved August 14, 1977
Plugging commenced August 14, 1977
Plugging completed August 14, 1977
Reason for abandonment of well or producing formation Dry Hole

If a producing well is abandoned, date of last production _____ 19____
Was permission obtained from the Conservation Division or its agents before plugging was commenced? Yes

Name of Conservation Agent who supervised plugging of this well _____
Producing formation _____ Depth to top _____ Bottom _____ Total Depth of Well 4460 Feet
Show depth and thickness of all water, oil and gas formations.

OIL, GAS OR WATER RECORDS

CASING RECORD

FORMATION	CONTENT	FROM	TO	SIZE	PUT IN	PULLED OUT
		0'	391'	8-5/8"	384.11'	None

Describe in detail the manner in which the well was plugged, indicating where the mud fluid was placed and the method or methods used in introducing it into the hole. If cement or other plugs were used, state the character of same and depth placed, from _____ feet to _____ feet for each plug set.

Spotted with 40 sacks cement & plug
at 400', 10 sacks cement and 1/2 sack
hulls at 40'.

(If additional description is necessary, use BACK of this sheet)

Name of Plugging Contractor Allied Cementing Company
Address Russell, Kansas

STATE OF KANSAS COUNTY OF SEDGWICK ss.
John D. Knightley Agent (employee of owner) or (owner or operator) of the above-described

well, being first duly sworn on oath, says: That I have knowledge of the facts, statements, and matters herein contained and the log of the above-described well as filed and that the same are true and correct. So help me God.

(Signature) [Signature]
301 S. Broadway, Wichita, Kansas (Address)

SUBSCRIBED AND SWORN TO before me this 17th day of August, 1977

My commission expires March 12, 1979 [Signature] Notary Public.

RECEIVED
STATE CORPORATION COMMISSION
AUG 19 1977
CONSERVATION DIVISION
Wichita, Kansas

Hummon Oil Company - Glenn Fisher #1
C NW NE Sec. 1-27S-12W
Pratt County, Kansas

Contractor: D. R. Lauck Oil Company, Inc.
301 S. Broadway
Wichita, Kansas 67202

Commenced: August 5, 1977
Completed: August 14, 1977

Drillers Log

Sand	185
Red Bed & Clay	395
Red Bed	976
Shale & Shells	1501
Anhydrite	1509
Shale & Shells	2075
Shale	2320
Shale & Shells	2755
Shale & Lime	3155
Shale & Shells	3340
Shale & Lime	3396
Lime & Shale	3497
Shale & Shells	3632
Shale	3710
Shale & Lime	3955
Lime	4070
Lime & Chert	4150
Lime	4270
Lime & Shale	4335
Lime	4460 RTD

RECEIVED
STATE CORPORATION COMMISSION

AUG 19 1977

CONSERVATION DIVISION
Wichita, Kansas