


STATE OF KANSAS
STATE CORPORATION COMMISSION
CONSERVATION DIVISION
P. O. BOX 17027
WICHITA, KANSAS 67217

FORM CP-4

WELL PLUGGING RECORD

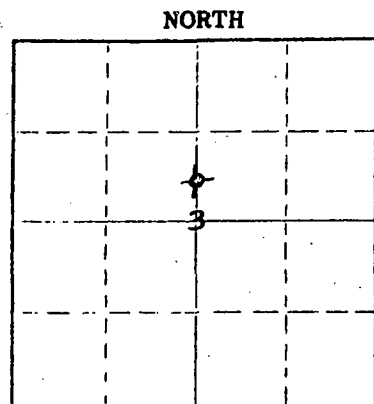

Locate well correctly on above Section Plat

Pratt County, Sec. 3 Twp. 27S Rge. 12W (W)
Location as "NE/CNW/SW" or footage from lines C S/2 N/2
Lease Owner Hummon Oil Company
Lease Name Lahtrop Well No. 1
Office Address 1725 Vickers-KSB&T Bldg., Wichita, Kansas
Character of Well (completed as Oil, Gas or Dry Hole) Dry Hole
Date well completed November 29, 1977
Application for plugging filed November 29, 1977
Application for plugging approved November 29, 1977
Plugging commenced November 29, 1977
Plugging completed November 29, 1977
Reason for abandonment of well or producing formation Dry Hole

If a producing well is abandoned, date of last production 19____
Was permission obtained from the Conservation Division or its agents before plugging was commenced? Yes

Name of Conservation Agent who supervised plugging of this well _____
Producing formation _____ Depth to top _____ Bottom _____ Total Depth of Well 3250 Feet
Show depth and thickness of all water, oil and gas formations.

OIL, GAS OR WATER RECORDS

CASING RECORD

FORMATION	CONTENT	FROM	TO	SIZE	PUT IN	PULLED OUT
		0'	339'	8-5/8"	332.20'	None

Describe in detail the manner in which the well was plugged, indicating where the mud fluid was placed and the method or methods used in introducing it into the hole. If cement or other plugs were used, state the character of same and depth placed, from _____ feet to _____ feet for each plug set.

Spotted with 40 sacks cement at 540',
25 sacks cement at 300', plug and
1/2 sack hulls and 12 sacks cement
at 40', 3 sacks cement in rat hole.

(If additional description is necessary, use BACK of this sheet)

Name of Plugging Contractor Halliburton Cementing Co.
Address Box 963, Pratt, Kansas 67124

STATE OF KANSAS COUNTY OF SEDGWICK ss.
John D. Knightley, Agent (employee of owner) or (owner or operator) of the above-described well, being first duly sworn on oath, says: That I have knowledge of the facts, statements, and matters herein contained and the log of the above-described well as filed and that the same are true and correct. So help me God.

(Signature) *John D. Knightley*
301 S. Broadway, Wichita, Kansas 67202
(Address)

SUBSCRIBED AND SWORN TO before me this 6th day of December, 1977

My commission expires March 12, 1979

Stella J. Lips
Notary Public.

RECEIVED
STATE CORPORATION COMMISSION

DEC - 7 1977

CONSERVATION DIVISION
Wichita, Kansas

Hummon Oil Company - Lahtrop #1
C S/2 N/2 Sec. 3-27S-12W
Pratt County, Kansas

Contractor: D. R. Lauck Oil Company, Inc.
301 S. Broadway
Wichita, Kansas 67202

Commenced: November 20, 1977
Completed: November 29, 1977

Drillers Log

Clay	130
Sand	200
Red Bed	342
Red Bed & Shale	1800
Shale & Lime	1849
Shale & Shells	2040
Shale & Lime	2310
Shale & Shells	2515
Shale & Lime	2752
Shale & Shells	2832
Shells	3060
Shale & Lime	3250 RTD

RECEIVED
STATE CORPORATION COMMISSION

DEC - 7 1977

CONSERVATION DIVISION
Wichita, Kansas