

This form shall be filed in duplicate with the Kansas Corporation Commission, 200 Colorado Derby Building, Wichita, Kansas 67202, within ten days after the completion of the well, regardless of how the well was completed.

Attach separate letter of request if the information is to be held confidential. If confidential, only file one copy. Information on side one will be of public record and side two will then be held confidential.

Circle one: Oil, Gas, Dry, SWD, OWWO, Injection. Type and complete ALL sections. Applications must be filed for dual completion, commingling, SWD and injection.

Attach wireline logs (i.e. electrical log, sonic log, gamma ray neutron log, etc.). KCC # (316) 263-3238. (Rules 82-2-105 & 82-2-125)

OPERATOR R.J. PATRICK OPERATING

API NO. 15-033-20,549,0000

ADDRESS P. O. Box 1314 LIBERAL KANSAS

COUNTY Comanche County FIELD COLLIER FLATS

**CONTACT PERSON R. J. Patrick PHONE 316-624-8483


PURCHASER UPG, Inc.

WELL NO. 4

ADDRESS 2140 N. HY 83 Liberal, Ks 67901


WELL LOCATION Comanche

DRILLING NRG Drilling CONTRACTOR ADDRESS P. O. Box 1157 Liberal, Ks 67901

2086 Ft. from South Line and 2086 Ft. from East Line of the NW/SE SEC. 35 TWP. 33 RGE. 20

PLUGGING N/A CONTRACTOR ADDRESS

WELL PLAT

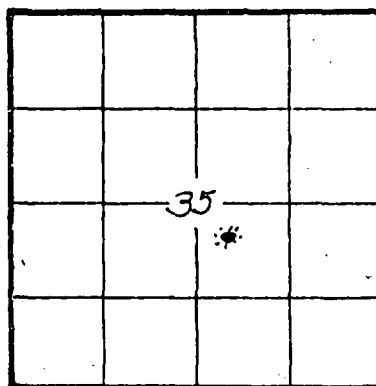

KCC _____ KGS _____ (Office Use)

TOTAL DEPTH 4830' PBTD 4816'

SPUD DATE 3/22/82 DATE COMPLETED 4/1/82

ELEV: GR 1800' DF KB 1811'

DRILLED WITH (CABLE) (ROTARY) (AIR) TOOLS

Amount of surface pipe set and cemented 643' of 12 1/4" hole. DV Tool Used? No

AFFIDAVIT

STATE OF Kansas, COUNTY OF Seward SS, I,

R. J. Patrick OF LAWFUL AGE, BEING FIRST DULY SWORN UPON HIS OATH, DEPOSES THAT HE IS Owner (FOR)(OF) R. J. Patrick Operating Comp

OPERATOR OF THE Robert Wimmer LEASE, AND IS DULY AUTHORIZED TO MAKE

THIS AFFIDAVIT FOR AND ON THE BEHALF OF SAID OPERATOR, THAT WELL NO. 4 ON


SAID LEASE HAS BEEN COMPLETED AS OF THE 23rd DAY OF April, 1982, AND THAT

ALL INFORMATION ENTERED HEREIN WITH RESPECT TO SAID WELL IS TRUE AND CORRECT.

FURTHER AFFIANT SAITH NOT.

(S) [Signature]

SUBSCRIBED AND SWORN BEFORE ME THIS 26th DAY OF April, 1982.

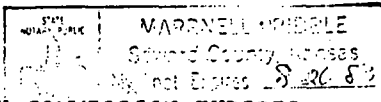

[Signature] NOTARY PUBLIC

MY COMMISSION EXPIRES: 8-26-83

**The person who can be reached by phone regarding any questions concerning this information. Within 45 days of completion, a witnessed initial test by the Commission is required if the well produces more than 25 BOPD or is located in a Basic Order Pool.

RECEIVED STATE OF KANSAS CORPORATION COMMISSION

OCT 11 1983

CONSERVATION DIVISION Wichita, Kansas

SIDE TWO

WELL LOG

Show all important zones of porosity and contents thereof; cored intervals, and all drill-stem tests, including depth interval tested, cushion used, time tool open, flowing and shut-in pressures, and recoveries.

SHOW GEOLOGICAL MARKERS, LOGS RUN, OR OTHER DESCRIPTIVE INFORMATION.

FORMATION DESCRIPTION, CONTENTS, ETC.	TOP	BOTTOM	NAME	DEPTH
See Attached				
SEE ATTACHMENT				

Report of all strings set — surface, intermediate, production, etc. CASING RECORD (New) or (Used)

Purpose of string	Size hole drilled	Size casing set (in O.D.)	Weight lbs/ft.	Setting depth	Type cement	Sacks	Type and percent additives
Conductor	30"	20"	-	40'	Grout	Grout	Ready Mix
Surface	12 1/4"	8 5/8"	23#	642'	HOWCO	550	Class H w/3% cc
Production	7 7/8"	5 1/2"	14#	4816'	Pozmix	150	1.8% Salt, 3/4 of 1% CFR2, 1/4# Floccle

LINER RECORD

PERFORATION RECORD

Top, ft.	Bottom, ft.	Sacks cement	Shots per ft.	Size & type	Depth interval
			2	1/2" jet	4761' to 4765'
			2	" "	4186' to 4202'

TUBING RECORD

Size	Setting depth	Packer set at
2 1/16th	4747'	4747
2 1/16th	4219'	

ACID, FRACTURE, SHOT, CEMENT SQUEEZE RECORD

Amount and kind of material used.	Depth interval treated
5000 gal 15% NE	4761' to 4765'
6000 gal. MCA & 15% NE	4186' to 4202'

Date of first production 4-23-82	Producing method (flowing, pumping, gas lift, etc.) Flowing & Pumping	Gravity 46 36
RATE OF PRODUCTION PER 24 HOURS	Oil 5 Duel 14 Duel	Gas 226,000 -
Disposition of gas (vented, used on lease or sold)	Water % 60	Gas-oil ratio 452
Sold	Perforations	4761 to 4765 4186 to 4202

