TYPE AFFIDAVIT OF COMPLETION FORM ACO-1 WELL HISTORY

Compt.____

SIDE ONE

Two (2) copies of this form shall be filed with the Kansas Corporation Commission, 200 Colorado Derby Building, Wichita, Kansas 67202, within thirty (30) days after the completion of a well, regardless of how the well was completed.

F ____ Attach separate letter of request if the information is to be held confidential. If confidential, only file one copy. Information on Side One will be of public record and Side Two will then be held confidential.

Applications must be made on dual completion, commingling, salt water disposal, injection and temporarily abandoned wells.

C ____ Attach one copy only wireline logs (i.e. electrical log, sonic log, gamma ray neutron log, etc.). (Rules 82-2-105 & 82-2-125) KCC# (316) 263-3238.

LICENSE # 6479 EXPIRATION DATE June 30, 1983

OPERATOR Layton Oil Company API NO. 001-25,530

ADDRESS P.O. Box 263 COUNTY Allen

Independence, Ks. 67301 FIELD Carlyle

** CONTACT PERSON Tom Hutter PROD. FORMATION Bartlesville

PHONE 331-1150

PURCHASER KOCK Industries, Inc. (Matador Pipeline) LEASE Howland "B"

ADDRESS P.O. Box 2256 WELL NO. 16-A

Wichita, Kansas 67201 WELL LOCATION SW SE SE

DRILLING CONTRACTOR Layton Oil Company 150 Ft. from South Line and

ADDRESS P.O. Box 263 700 Ft. from East Line of

Independence, Ks. 67301 the SE (Qtr.) SEC 4 TWP 24 RGE 18 (E) (W)

PLUGGING CONTRACTOR ADDRESS

WELL PLAT

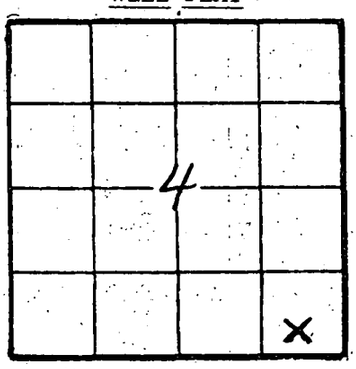

(Office Use Only)

KCC____

KGS____

SWD/REP____

PLG.____

TOTAL DEPTH 934' PBTD

SPUD DATE 4-13-82 DATE COMPLETED 4-19-82

ELEV: GR 999.07 DF KB

DRILLED WITH (CABLE) (ROTARY) (AIR) TOOLS.

DOCKET NO. OF DISPOSAL OR REPRESSURING WELL BEING USED TO DISPOSE OF WATER FROM THIS LEASE ____.

Amount of surface pipe set and cemented 50' DV Tool Used? ____.

THIS AFFIDAVIT APPLIES TO: (Circle ONE) Oil, Gas, Shut-in Gas, Dry, Disposal, Injection, Temporarily Abandoned, OWWO. Other____.

ALL REQUIREMENTS OF THE STATUTES, RULES AND REGULATIONS PROMULGATED TO REGULATE THE OIL AND GAS INDUSTRY HAVE BEEN FULLY COMPLIED WITH.

A F F I D A V I T

Tom Hutter, being of lawful age, hereby certifies that:

I am the Affiant, and I am familiar with the contents of the foregoing Affidavit. The statements and allegations contained therein are true and correct.

Tom Hutter
(Name)

SUBSCRIBED AND SWORN TO BEFORE ME this 19 day of August, 19 83.

Dorothy Kelly
(NOTARY PUBLIC)

MY COMMISSION EXPIRES: Sept. 5, 1984

DOROTHY KELLY
Notary Public
Montgomery County
State of Kansas

** The person who can be reached by phone regarding any questions concerning this information.

AUG 23 1983
CONSERVATION DIVISION
Wichita, Kansas