

STATE CORPORATION COMMISSION OF KANSAS  
OIL & GAS CONSERVATION DIVISION  
WELL COMPLETION OR RECOMPLETION FORM  
ACO-1 WELL HISTORY  
DESCRIPTION OF WELL AND LEASE

Operator: License # 3180  
Name Deutsch Oil Company  
Address 107 North Market - Suite 1008  
City/State/Zip Wichita, KS 67202

Purchaser

Operator Contact Person Kent A. Deutsch  
Phone 316-267-7551

Contractor: License # 5929  
Name Duke Drilling Co., Inc.

Wellsite Geologist Kent A. Deutsch  
Phone (316) 267-7551

Designate Type of Completion  
 New Well  Re-Entry  Workover  
 Oil  SWD  Temp Abd  
 Gas  Inj  Delayed Comp.  
 Dry  Other (Core, Water Supply etc.)  
If OWN: old well info as follows:  
Operator  
Well Name  
Comp. Date  
Old Total Depth


WELL HISTORY

Drilling Method:  
 Mud Rotary  Air Rotary  Cable  
7-20-87 7-28-87 7-28-87  
Spud Date Date Reached TD Completion Date  
4188  
Total Depth PBTD 308  
Amount of Surface Pipe Set and Cemented at feet  
Multiple Stage Cementing Collar Used? Yes No  
If yes, show depth set feet  
If alternate 2 completion, cement circulated from feet depth to w/SX cmt  
Cement Company Name  
Invoice #

API No. 15-151.21.845-0000  
County Pratt  
S/2 S/2 NE Sec. 26 Twp. 26 Rge. 12 East  
2970 Ft North from Southeast Corner of Section  
1320 Ft West from Southeast Corner of Section  
(Note: Locate well in section plat below)

Lease Name Allen Well # 1-26  
Field Name  
Producing Formation  
Elevation: Ground 1858 KB 1863

Section Plat

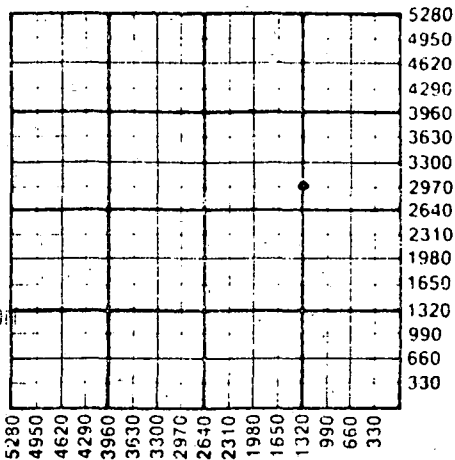

RECEIVED  
STATE CORPORATION COMMISSION  
OIL & GAS CONSERVATION DIVISION  
20 1987  
820 87  
Wichita, Kansas

WATER SUPPLY INFORMATION

Disposition of Produced Water:  Disposal  Repressuring  
Docket #

Questions on this portion of the ACO-1 call:

Water Resources Board (913) 296-3717

Source of Water:  
Division of Water Resources Permit # T-87-288

Groundwater 2970 Ft North from Southeast Corner  
(Well) 1320 Ft West from Southeast Corner of  
Sec 26 Twp 26 Rge 12 East X West  
 Surface Water Ft North from Southeast Corner  
(Stream, pond etc) Ft West from Southeast Corner  
Sec Twp Rge East West  
 Other (explain)  
(purchased from city, R.W.D. #)

INSTRUCTIONS: This form shall be completed in triplicate and filed with the Kansas Corporation Commission, 200 Colorado Derby Building, Wichita, Kansas 67202, within 120 days of the spud date of any well. Rule 82-3-130, 82-3-107 and 82-3-106 apply. Information on side two of this form will be held confidential for a period of 12 months if requested in writing and submitted with the form. See rule 82-3-107 for confidentiality in excess of 12 months. One copy of all wireline logs and drillers time log shall be attached with this form. Submit CP-4 form with all plugged wells. Submit CP-111 form with all temporarily abandoned wells.

All requirements of the statutes, rules and regulations promulgated to regulate the oil and gas industry have been fully complied with and the statements herein are complete and correct to the best of my knowledge.

Signature Kent A. Deutsch  
Title President Date 8-20-87

Subscribed and sworn to before me this 20th day of August 1987  
Notary Public Pamela I. Connelly

Date Commission Expires March 26, 1988

PAMELA I. CONNELLY  
NOTARY PUBLIC  
STATE OF KANSAS  
MY APPT. EXPIRES 3-26-88

K.C.C. OFFICE USE ONLY  
 Letter of Confidentiality Attached  
 Wireline Log Received  
 Drillers Time Log Received  
Distribution  
 KCC  SWD/Rep  NGPA  
 KGS  Plug  Other  
(Specify)

Sec. 26 Twp. 26 Rge. 12 East

Operator Name Deutsch Oil Company Lease Name Allen Well # 1-26

Sec. 26 Twp. 26 Rge. 12  East  West County Pratt

WELL LOG

INSTRUCTIONS: Show important tops and base of formations penetrated. Detail all cores. Report all drill stem tests giving interval tested, time tool open and closed, flowing and shut-in pressures, whether shut-in pressure reached static level, hydrostatic pressures, bottom hole temperature, fluid recovery, and flow rates if gas to surface during test. Attach extra sheet if more space is needed. Attach copy of log.

Drill Stem Tests Taken  Yes  No  
 Samples Sent to Geological Survey  Yes  No  
 Cores Taken  Yes  No

Formation Description  
 Log  Sample

Name	Top	Bottom
Heebner Sh.	3451	-1588
Douglas Sh.	3491	-1628
Brown Lime	3636	-1773
Lansing	3658	-1795
Base K.C.	3994	-2131
Mississippi	4092	-2229

RELEASED

SEP 22 1988

FROM CONFIDENTIAL

CASING RECORD <input type="checkbox"/> New <input checked="" type="checkbox"/> Used							
Report all strings set-conductor, surface, intermediate, production, etc.							
Purpose of String	Size Hole Drilled	Size Casing Set. (in O.D.)	Weight Lbs./Ft.	Setting Depth	Type of Cement	#Sacks Used	Type and Percent Additives
Surface	12 1/4"	8-5/8"	20#	308'	60/40 poz.	200	2% gel 3% cc.

PERFORATION RECORD		Acid, Fracture, Shot, Cement Squeeze Record (Amount and Kind of Material Used)	
Shots Per Foot	Specify Footage of Each Interval Perforated		Depth

TUBING RECORD	Size	Set At	Packer at	Liner Run <input type="checkbox"/> Yes <input type="checkbox"/> No

Date of First Production	Producing Method <input type="checkbox"/> Flowing <input type="checkbox"/> Pumping <input type="checkbox"/> Gas Lift <input type="checkbox"/> Other (explain).....			

Estimated Production Per 24 Hours	Oil	Gas	Water	Gas-Oil Ratio	Gravity
	Bbls	MCF	Bbls	CFPB	

METHOD OF COMPLETION Production Interval

Disposition of gas:  Vented  Open Hole  Perforation  
 Sold  Other (Specify) .....  
 Used on Lease  Dually Completed  Commingled

PAMELA I. CONNELLY  
 NOTARY PUBLIC  
 STATE OF KANSAS  
 MY EXP. 12/31/88

15-15-21845-0000

# Deutsch Oil Company

1008 Bitting Building

107 N. Market St.

Wichita, KS 67202

(316) 267-7551

ACO-1 ALLEN #1-26 26-26-12W PRATT County Ks

DRILL STEM TEST INFO.

DST No. 1

4093 to 4120

15-60-45-120

REC: 615 FT GAS IN PIPE

50 FT. SL. OIL CUT GSY. MUD

HP: 2080# - 2002#

IFP: 33# - 33#

ISIP: 363#

FFP: 33# - 33#

FSIP: 615#

BHT: 119°F

RECEIVED  
STATE CORPORATION COMMISSION

AUG 27 1987

8-27-87  
CONSERVATION DIVISION  
Wichita, Kansas

RELEASED

SEP 22 1988

FROM CONFIDENTIAL