

STATE CORPORATION COMMISSION OF KANSAS
OIL & GAS CONSERVATION DIVISION
WELL COMPLETION OR RECOMPLETION FORM
ACO-1 WELL HISTORY
DESCRIPTION OF WELL AND LEASE

Operator: License # 9069
Name General Oil Company, Inc.
Address 1540 N. Broadway
Suite 202
City/State/Zip Wichita, Ks. 67214

Purchaser none

Operator Contact Person John C. Bannister
Phone (316) 263-8588

Contractor: License # 5122
Name Woodman-Iannitti Drilling Co.

Wellsite Geologist David E. Brewer
Phone (316) 263-8588

Designate Type of Completion

New Well Re-Entry Workover
 Oil SWD Temp Abd
 Gas Inj Delayed Comp.
 Dry Other (Core, Water Supply etc.)

If ONWO: old well info as follows:

Operator
Well Name
Comp. Date Old Total Depth.....

WELL HISTORY

Drilling Method:

Mud Rotary Air Rotary Cable

5-11-87 5-20-87 5-20-87
Spud Date Date Reached TD Completion Date

4410'
Total Depth PBTD

Amount of Surface Pipe Set and Cemented at 333 feet
Multiple Stage Cementing Collar Used? Yes No
If yes, show depth set.....feet
If alternate 2 completion, cement circulated
from.....feet depth to.....w/.....SX cmt
Cement Company Name
Invoice #

API NO. 15-151,21,836-0000

County Pratt

NE NE NW 25 26S 12 East
..... Sec..... Twp..... Rge..... West

4950' Ft North from Southeast Corner of Section
2970' Ft West from Southeast Corner of Section
(Note: Locate well in section plat below)


Lease Name Allen Well # 1

Field Name Wildcat

Producing Formation.....

Elevation: Ground 1862' KB 1862'

Section Plat

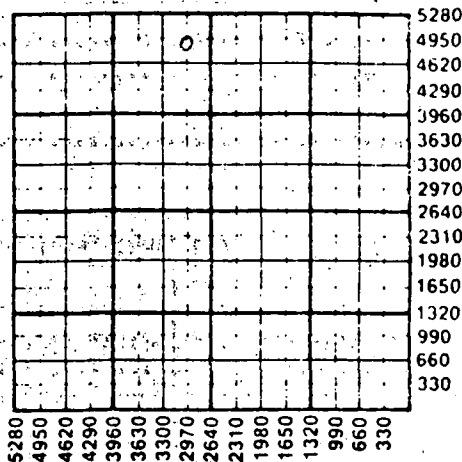

WATER SUPPLY INFORMATION

Disposition of Produced Water: Disposal
Docket # Repressuring

Questions on this portion of the ACO-1 call:

Water Resources Board (913) 296-3717

Source of Water:
Division of Water Resources Permit #.....

Groundwater.....Ft North from Southeast Corner
(Well)Ft West from Southeast Corner of
Sec 25 Twp 26S Rge 12 East West
Drilled 5 1/2" well on west side of Reserve
Pit: 95' deep, 34' w.l. Plugged
Surface Water.....Ft North from Southeast Corner
(Stream, pond etc).....Ft West from Southeast Corner
Sec Twp Rge East West
Other (explain).....
(purchased from city, R.W.D. #)

INSTRUCTIONS: This form shall be completed in triplicate and filed with the Kansas Corporation Commission, 200 Colorado Derby Building, Wichita, Kansas 67202, within 120 days of the spud date of any well. Rule 82-3-130, 82-3-107 and 82-3-106 apply. Information on side two of this form will be held confidential for a period of 12 months if requested in writing and submitted with the form. See rule 82-3-107 for confidentiality in excess of 12 months. One copy of all wireline logs and drillers time log shall be attached with this form. Submit CP-4 form with all plugged wells. Submit CP-11 form with all temporarily abandoned wells.

All requirements of the statutes, rules and regulations promulgated to regulate the oil and gas industry have been fully complied with and the statements herein are complete and correct to the best of my knowledge.

Signature John C. Bannister
President Date 8-3-87

Subscribed and sworn to before me this 3rd day of August
Katherine J. Manh
Katherine J. Manh
Date Commission Expires June 2, 1991

K.C.C. OFFICE USE ONLY
 Letter of Confidentiality Attached
 Wireline Log Received
 Drillers Timelog Received
Distribution
 KCC SWD/Rep NGPA
 KGS Plug Other
(Specify)
8-1-87
AUG 1 1987



Sec 25 Twp 26 Rge 12