

This form must be filed in triplicate with the Kansas Corporation Commission, 200 Colorado Derby Building, Wichita, Kansas 67202, within five days after the completion of the well, regardless of how the well was completed. Circle one: Oil, gas dry, SWD, OWWO, injection. Please type. Complete ALL sections. Applications must be filed for dual completion, commingling, salt water disposal and injection. Attach wireline logs (i.e. electrical log, sonic log, gamma ray neutron log, etc.) KCC#-(316) 263-3238.

OPERATOR AMERICAN CONTINENTAL ENERGY, INC. API NO. 15-092-20.767-00-00
 ADDRESS 1845 Sherman Street, Suite 665 COUNTY KEARNY
Denver, Colorado 80203 FIELD HUGOTON

**CONTACT PERSON KARL G. SIEG LEASE FERTIG
 PHONE (303) 863-1227 PROD. FORMATION WINFIELD


PURCHASER NORTHERN NATURAL GAS COMPANY WELL NO. 2-H
 ADDRESS 2223 Dodge Street WELL LOCATION C NW/4
Omaha, Nebraska 68102 1320' Ft. from North Line and
1320' Ft. from West Line of

DRILLING CONTRACTOR ANTHES RESOURCE SERVICES, INC. the NW/4 SEC. 28 TWP. 22 RGE. 37

ADDRESS 100 South Main, Suite 210
Wichita, Kansas 67202

PLUGGING CONTRACTOR N/A
 ADDRESS N/A

TOTAL DEPTH 2731' PBDT 2691'
 SPUD DATE 5/27/82 DATE COMPLETED 8/10/82
 ELEV: GR 3275 DF KB 3286'

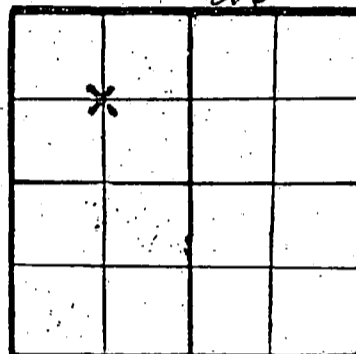

WELL PLAT
 (Quarter) or (Full) Section - Please indicate.

KCC _____
 KGS _____
 MISC. _____

DRILLED WITH ~~(CABLE)~~ (ROTARY) ~~(AIR)~~ TOOLS (New) / ~~(PIPE)~~ casing.
 Report of all strings set - surface, intermediate, production, etc.

Purpose of string	Size hole drilled	Size casing set (in O.D.)	Weight lbs/ft.	Setting depth	Type cement	Sacks	Type and percent additives
SURFACE	12 1/4"	8 5/8"	20#	302'	Class H	250	3% CaCl
PRODUCTION	7 7/8"	5 1/2"	14#	2731'	LITE 50/50 POZ-MIX	400	18% Salt
						200	

LINER RECORD			PERFORATION RECORD		
Top, ft.	Bottom, ft.	Sacks cement	Shots per ft.	Size & type	Depth interval
N/A	N/A	N/A			
TUBING RECORD			2 JSPF	3/8" JET	2592'-2712'
Size	Setting depth	Packer set at			
2 3/8"	2680'	N/A			

ACID, FRACTURE, SHOT, CEMENT SQUEEZE RECORD	
Amount and kind of material used	Depth interval treated
HOWCO acidized with 2500 gallons of HCl @ 15% and water fraced	
with 2000 Bbl's of water with 100,000 lbs of river sand @ 100	2592'-2712'
BPM.	

TEST DATE: <u>8/10/82</u>		PRODUCTION	
Date of first production	Producing method (flowing, pumping, gas lift, etc.)	A.P.I. Gravity	
8/10/82	PUMPING AND FLOWING	N/A	
RATE OF PRODUCTION PER 24 HOURS	OH	Gas	Water
	N/A	286 MCF	% N/A
Disposition of gas (vented, used on lease or sold)		Producing interval(s)	
VENTED		2592'-2712'	

** The person who can be reached by phone regarding any questions concerning this information. RECEIVED
 A witnessed initial test by the Commission is required if the well produces more than 25 BOPD or is located in a Basic Order Pool.

DEC 19 1983

Name of lowest fresh water producing stratum DAKOTA SANDST Depth 550'
 Estimated height of cement behind pipe Circulated

WELL LOG

SHOW GEOLOGICAL MARKERS, LOG NUM, OR OTHER DESCRIPTIVE INFORMATION.

Show all important zones of porosity and contents thereof, cored intervals, and all drill-stem tests, including depth interval tested, cushion used, time tool open, flowing and shut-in pressures, and recoveries.

FORMATION DESCRIPTION, CONTENTS, ETC.	TOP	BOTTOM	NAME	DEPTH
BASE OF THE STONE CORRAL KRIDER WINFIELD UPPER FT. RILEY		2138' 2592' 2640' 2698'		(+1148) (+694) (+646) (+588)
GAMMA RAY/NEUTRON LOG				

USE ADDITIONAL SHEETS, IF NECESSARY, TO COMPLETE WELL RECORD.

A F F I D A V I T

STATE OF KANSAS, COUNTY OF KEARNY SS,

KARL G. SIEG OF LAWFUL AGE, BEING FIRST DULY SWORN UPON HIS OATH, DEPOSES AND SAYS:

THAT HE IS EXECUTIVE VICE PRESIDENT FOR AMERICAN CONTINENTAL ENERGY, INC. OPERATOR OF THE FERTIG LEASE, AND IS DULY AUTHORIZED TO MAKE THIS AFFIDAVIT FOR AND ON BEHALF OF SAID OPERATOR, THAT WELL NO. 2-H ON SAID LEASE HAS BEEN COMPLETED AS OF THE 10th DAY OF AUGUST 19 82, AND THAT ALL INFORMATION ENTERED HEREIN WITH RESPECT TO SAID WELL IS TRUE AND CORRECT.

FURTHER AFFIANT SAITH NOT.

(S) *Karl G. Sieg*
 SUBSCRIBED AND SWORN TO BEFORE ME THIS 13th DAY OF August 19 82

William W. Mason
 NOTARY PUBLIC

MY COMMISSION EXPIRES: 7-21-1983