


15-151-10563-0000

STATE OF KANSAS  
STATE CORPORATION COMMISSION

Give All Information Completely  
Make Required Affidavit  
Mail or Deliver Report to:  
Conservation Division  
State Corporation Commission  
800 Biting Building  
Wichita, Kansas

WELL PLUGGING RECORD

NORTH

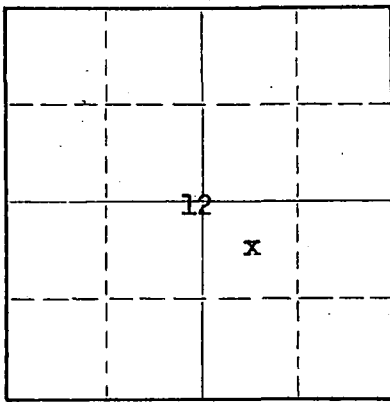

Locate well correctly on above  
Section Plat

Pratt County. Sec. 12 Twp. 26S Rge. 12 (E) 12 (W)  
Location as "NE/CNW/SWK" or footage from lines S/2 NE/4 SE/4  
Lease Owner Monsanto Chemical Company  
Lease Name Ford Well No. 6  
Office Address P. O. Box 580, Pratt, Kansas  
Character of Well (completed as Oil, Gas or Dry Hole) Oil Well  
Date well completed November 17, 19 45  
Application for plugging filed February 28, 19 56  
Application for plugging approved February 29, 19 56  
Plugging commenced March 31, 19 56  
Plugging completed April 2, 19 56  
Reason for abandonment of well or producing formation Insufficient production to justify operating.  
If a producing well is abandoned, date of last production August 19 54  
Was permission obtained from the Conservation Division or its agents before plugging was commenced? Yes

Name of Conservation Agent who supervised plugging of this well Merle Rives  
Producing formation Viola Depth to top 4136' Bottom \_\_\_\_\_ Total Depth of Well 4142 Feet  
Show depth and thickness of all water, oil and gas formations.

OIL, GAS OR WATER RECORDS

CASING RECORD

FORMATION	CONTENT	FROM	TO	SIZE	PUT IN	PULLED OUT
				8-5/8"	324'	None
				5 1/2"	4139'	1940'

Describe in detail the manner in which the well was plugged, indicating where the mud fluid was placed and the method or methods used in introducing it into the hole. If cement or other plugs were used, state the character of same and depth placed, from \_\_\_\_\_ feet to \_\_\_\_\_ feet for each plug set.

Plugged back with sand from 4141' to 4130' with 5 sacks of cement on top of sand. Shot pipe off @ 1940' and pulled 3 joints. Circulated heavy mud. Finished pulling casing. Plugged with heavy mud to 300', set rock plug @ 300' with 20 sacks of cement on top of plug. Heavy mud to 35' and set rock plug @ 35' with 10 sacks of cement to base of cellar.

(If additional description is necessary, use BACK of this sheet)

Name of Plugging Contractor West Supply Co., Inc.  
Address Chase, Kansas

STATE OF KANSAS, COUNTY OF PRATT  
J. B. Gibbs ss.  
(employee of owner) or (owner/operator) of the above-described well, being first duly sworn on oath, says: That I have knowledge of the facts, statements, and matters herein contained and the log of the above-described well as filed and that the same are true and correct. So help me God.

(Signature) [Signature]  
P. O. Box 580, Pratt, Kansas  
(Address)

SUBSCRIBED AND SWORN to before me this 3rd day of April, 1956

REC Merle J. Combs  
STATE CORPORATION COMMISSION Notary Public.

My commission expires September 19, 1959

APR 5 - 1956  
4-5-56  
CONSERVATION DIVISION  
Wichita, Kansas

PLUGGING  
SEC 12 T 26 R 12W  
PAGE 42 LINE 14

15-151-18563-0000

WELL LOG BUREAU - KANSAS GEOLOGICAL SOCIETY  
412 Union National Bk. Bldg., Wichita, Kansas

Company - LION OIL CO.  
Farm - Ford


No. 6

SEC. 12 T. 26 R. 12 W  
CS/2 NE SE

Total Depth. 4143'  
Comm. 10-19-45  
Shot or Treated.  
Contractor.  
Issued. 6-1-46

Comp. 11-17-45

County. Pratt  
KANSAS

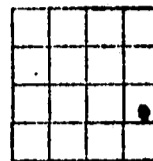

Elevation. \_\_\_\_\_

Production. Phy.Pot. 84 BO.

CASING:

8 5/8" 324' Cem.  
5 1/2" 4139' Cem.

Figures Indicate Bottom of Formations.

surface clay	0-210	shale, sticky	4045
red bed	400	shale	4135
shale strks, sand	600	shale & lime	4143
shale	660	Total Depth.	
shale & shells	740		
red bed	770	Tops:	
shale w shells	1220	transing	3614
chalk	1280	Mississippian	3975
shale & shells	1380	Viola	4138
salt	1460		
shale & shells	1475		
salt, shale & shells	1645		
lime	1805		
lime shells & shale	2025		
lime strks, shale	2092		
lime shells & shale	2155		
lime & shale	2195		
shale, lime shells	2255		
shale & lime strks	2320		
lime & shale	2475		
shale & shells	2530		
lime & shale strks	2610		
shale & shells	2685		
shale	2727		
shale & shells	2815		
shale & lime shells (rough)	2875		
shale & lime strks	2995		
shale & shells	3020		
shale & lime	3155		
shale	3170		
chalky lime	3230		
lime & shale	3280		
shale strks lime	3380		
lime & shale	3520		
shale	3540		
shale & lime	3585		
lime strks, shale	3685		
lime	3715		
lime, strks shale	3755		
shale & shells	3780		
shale & lime strks	3834		
shale & lime shells	3860		
lime & shale	3900		
lime	3940		
shale & lime	3975		
chert & lime	3989		
chert	4025		
shale	4036		

**PLUGGING**  
FILE SEC 12 T 26 R 12 W  
BOOK PAGE 42 LINE 14

RECEIVED  
MAY 1 1946  
3-1-56  
CONSERVATION DIVISION  
Wichita, Kansas