

STATE OF KANSAS  
STATE CORPORATION COMMISSION

WELL PLUGGING RECORD


OR

FORMATION PLUGGING RECORD

Strike out upper line when reporting plugging off formations.

Give All Information Completely  
Make Required Affidavit  
Mail or Deliver Report to:  
Conservation Division  
State Corporation Commission  
800 Bitting Building  
Wichita, Kansas

NORTH

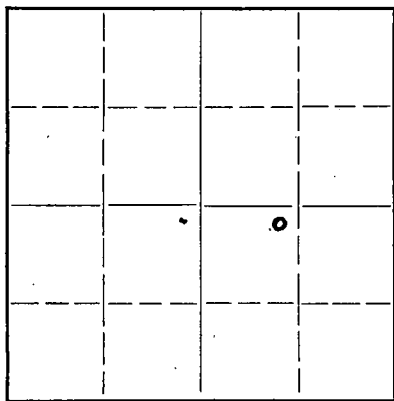

Locate well correctly on above Section Plat

Pratt County, Sec. 12, Twp. 26, Rge. (E) 12 (W)

Location as "NE 1/4 NW 1/4 SW 1/4" or footage from lines NE Cor. NW 1/4 SE 1/4

Lease Owner Lion Oil Refining Co.

Lease Name Vishu Ford Well No. 2

Office Address El Dorado, Arkansas

Character of Well (completed as Oil, Gas or Dry Hole) Dry Hole

Date well completed May 16 1943

Application for plugging filed May 16 1943

Application for plugging approved May 17 1943

Plugging commenced May 17 1943

Plugging completed May 22 1943

Reason for abandonment of well or producing formation Dry Hole

If a producing well is abandoned, date of last production 19

Was permission obtained from the Conservation Division or its agents before plugging was commenced? Yes

Name of Conservation Agent who supervised plugging of this well E. J. Alexander

Producing formation Depth to top Bottom Total Depth of Well 416.1 Feet

Show depth and thickness of all water, oil and gas formations.


OIL, GAS OR WATER RECORDS

CASING RECORD

Formation	Content	From	To	Size	Put In	Pulled Out
				5 1/2"	41.50'	26.00'
				8 5/8"	3.55'	None

Describe in detail the manner in which the well was plugged, indicating where the mud fluid was placed and the method or methods used in introducing it into the hold. If cement or other plugs were used, state the character of same and depth placed, from feet to feet for each plug set.

Cemented from 416.1' - 41.31'. Cemented from 3.55' - 3.35' and from 26' to top

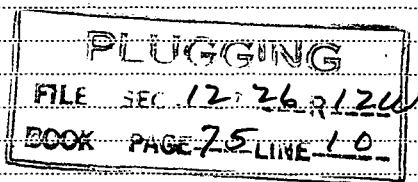

(If additional description is necessary, use BACK of this sheet)

Correspondence regarding this well should be addressed to Lion Oil Refining Co. Address El Dorado, Arkansas.

STATE OF Kansas, COUNTY OF Reno, ss.

Vernon Hayes (employee of owner) or (owner or operator) of the above-described well, being first duly sworn on oath, says: That I have knowledge of the facts, statements, and matters herein contained and the log of the above-described well as filed and that the same are true and correct. So help me God.

(Signature) Vernon Hayes

(Address)

SUBSCRIBED AND SWORN to before me this 28 day of May, 1943

My commission expires Nov. 4, 1943

Ruth R. Roper Notary Public



LION OIL REFINING COMPANY

Viola Ford Well No. 2

330' from North line and 330' from East line of NW $\frac{1}{4}$  of SE $\frac{1}{4}$  of Sec. 12-26S-12W, Pratt County, Kansas.

Contractor: The R. W. Rine Drilling Company

Commenced: April 14, 1943 - Completed: May 24, 1943

LOG

Clay	Top-	210	
Clay, Sand & Shale		354	8-5/8" casing cemented at 354'
Red Bed, Shale & Sand		660	
Sand		1260	
Shale & Sand		1625	
Shale & Lime		1765	
Lime		1880	
Lime & Chert		1975	
Lime & Shale		2045	
Sandy Lime		2090	
Lime		2210	
Broken Lime & Shale		2340	
Lime		2385	
Shale		2630	
Sandy Lime & Sand		2675	
Shale & Lime		2735	
Lime & Shale		3078	
Lime		3170	
Shale		3185	
Lime		3376	
Lime & Shale		3470	
Lime		3591	
Shale		3635	
Lime		3922	
Lime & Shale		3980	
Chert		4036	
Chert & Shale		4074	
Lime & Shale		4112	
Shale		4150	5-1/2" casing cemented at 4150'
Lime		4154	Total depth 4154'
			Dry and abandoned

State of Kansas ) ss.  
County of Barton)

I, C. H. Todd, do hereby certify that the above is a true and correct copy of the log of Viola Ford Well No. 2, located 330' from the east line and 330' from the North line of NW $\frac{1}{4}$  of SE $\frac{1}{4}$ , Section 12, Township 26S, Range 12W, Pratt County, Kansas.

*C. H. Todd*

Sworn to and subscribed before me this 26th day of May, 1943.

*O. O. Deighton*  
Notary Public

My Commission Expires December 4th 1943

PLUGGING  
FILE SEC. 12 26-12W  
BOOK PAGE 75 LINE 10

