


WELL PLUGGING RECORD

Give All Information Completely  
Make Required Affidavit  
Mail or Deliver Report to:  
Conservation Division  
State Corporation Commission  
211 No. Broadway  
Wichita, Kansas

Barber County, Sec. 36 Twp. 34S Rge. (E) 14 (W)

Location as "NE/CNW/SW" or footage from lines SW/4 SE/4 NE/4  
Lease Owner Skelly Oil Company  
Lease Name Louise Morrow Well No. 1  
Office Address P. O. Box 1650, Tulsa, Oklahoma  
Character of Well (completed as Oil, Gas or Dry Hole) Dry Hole  
Date well completed October 18, 19 65  
Application for plugging filed October 19, 19 65  
Application for plugging approved October 20, 19 65  
Plugging commenced October 19, 19 65  
Plugging completed October 19, 19 65  
Reason for abandonment of well or producing formation Dry Hole

NORTH

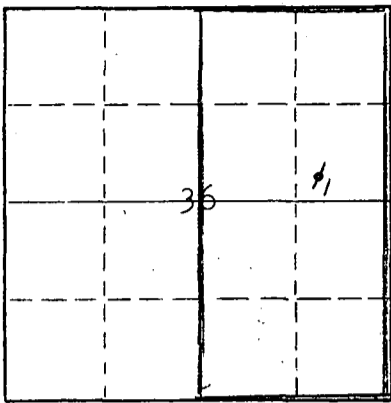

Locate well correctly on above Section Plat

If a producing well is abandoned, date of last production 19  
Was permission obtained from the Conservation Division or its agents before plugging was commenced? Yes (verbally)

Name of Conservation Agent who supervised plugging of this well Mr. A. Elving  
Producing formation Depth to top Bottom Total Depth of Well 4929 Feet  
Show depth and thickness of all water, oil and gas formations.

OIL, GAS OR WATER RECORDS

CASING RECORD

FORMATION	CONTENT	FROM	TO	SIZE OD	PUT IN	PULLED OUT
Mississippian	Dry	4852'		8-5/8"	371'	None

Describe in detail the manner in which the well was plugged, indicating where the mud fluid was placed and the method or methods used in introducing it into the hole. If cement or other plugs were used, state the character of same and depth placed, from feet to feet for each plug set.

Mud 4929' to 306'  
Hull bridge 306' to 296'  
25 sacks cement 296' to 231'  
Mud 231' to 40'  
Hull bridge 40' to 30'  
10 sacks of cement 30' to Base cellar  
Surface soil Cellar to Surface

RECEIVED  
STATE CORPORATION COMMISSION  
NOV 29 1965  
11-29-65  
CONSERVATION DIVISION  
Wichita, Kansas

(If additional description is necessary, use BACK of this sheet)  
Name of Plugging Contractor Leben Drilling, Inc.  
Address P. O. Box 486, Great Bend, Kansas

STATE OF Nebraska, COUNTY OF Red Willow, ss.  
C. F. Bass (employee of owner) or (owner/lessee) of the above-described well, being first duly sworn on oath, says: That I have knowledge of the facts, statements, and matters herein contained and the log of the above-described well as filed and that the same are true and correct. So help me God.

(Signature) C. F. Bass  
P. O. Box 649, McCook, Nebr. 69001  
(Address)

SUBSCRIBED AND SWORN TO before me this 24th day of November, 19 65  
C. E. Lindsey  
Notary Public.

My commission expires June 13, 1969

15-007-30362-0000

DRILLER'S LOG

COMPANY: Skelly Oil Company  
 CONTRACTOR: LEBEN DRILLING, INC.  
 FARM: Louise Morrow #1  
 LOCATION: SW SE NE Sec. 36-34s-14w  
 Barber County, Kansas  
 COMMENCED: 10-8-65  
 COMPLETED: 10-19-65

0 180 Red Bed  
 180 380 Red Bed and Shale  
 380 815 Shale  
 815 1785 Red Bed, Shale and Shells  
 1785 1875 Shale and Lime  
 1875 2440 Lime and Shale  
 2440 2660 Lime  
 2660 2900 Lime and Shale  
 2900 4135 Shale and Lime  
 4135 4364 Lime and Shale  
 4364 4930 Lime  
 4930 Rotary Total Depth D & A

Set 8 5/8" used surface casing @ 380' w/225 sks HA5 - Cement circulated.

I, Leslie Kite, do hereby certify that the above and foregoing is a true and correct copy of the log of the Louise Morrow #1, located SW SE NE of Section 36, Township 34 South, Range 14 West, Barber County, Kansas, as reflected by the files of Leben Drilling, Inc.

*Leslie Kite*  
 Leslie Kite  
 RECEIVED  
 STATE CORPORATION COMMISSION

STATE OF KANSAS )  
 ) SS  
 COUNTY OF BARTON)

OCT 26 1965  
 10-26-65  
 CONSERVATION DIVISION  
 Wichita, Kansas

Subscribed and sworn to before me, a Notary Public, in and for Barton County, Kansas, this 22nd day of October, 1965.

*Ulanda Nichols*  
 Ulanda Nichols

My Commission Expires April 1, 1967