

STATE OF KANSAS
STATE CORPORATION COMMISSION

WELL PLUGGING RECORD

Give All Information Completely
Make Required Affidavit
Mail or Deliver Report to:
Conservation Division
State Corporation Commission
800 Bittling Building
Wichita, Kansas

OR
FORMATION PLUGGING RECORD

Strike out upper line
when reporting plug-
ging of formations.

Pratt County. Sec. 15 Twp. 26S Rge. 12 (W)

Location as "NE 1/4 NW 1/4 SW 1/4" or footage from lines. NE/4 NE/4 NE/4

Lease Owner **Sohio Petroleum Company**

Lease Name **Stalcup** Well No. **1**

Office Address **Box 609, Russell, Kansas**

Character of Well (completed as Oil, Gas or Dry Hole) **Dry Hole**

Date well completed **October 31** 19 **46**

Application for plugging filed **December 10** 19 **46**

Application for plugging approved **December 10** 19 **46**


Plugging commenced **December 11** 19 **46**

Plugging completed **December 11** 19 **46**

Reason for abandonment of well or producing formation **Dry hole**

If a producing well is abandoned, date of last production **Dry hole** 19

Was permission obtained from the Conservation Division or its agents before plugging was commenced? **Yes, by telephone**

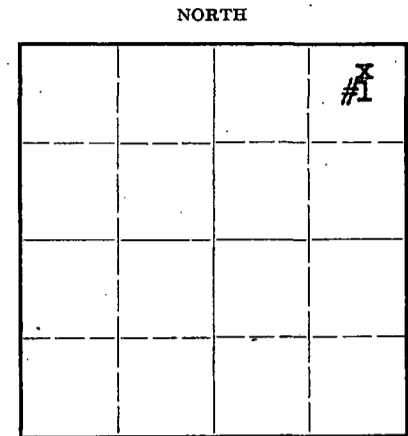

Locate well correctly on above
Section Plat

Name of Conservation Agent who supervised plugging of this well **Mr. Herb Kerr**

Producing formation **None** Depth to top Bottom Total Depth of Well **4346** Feet

Show depth and thickness of all water, oil and gas formations.

OIL, GAS OR WATER RECORDS


CASING RECORD

| Formation | Content | From | To | Size | Put In | Pulled Out |
|--|---------|------|----|------------------|---------------|---------------|
| No commercial oil nor gas shows from top to bottom | | | | 8 5/8" 5 1/2" | 365' 4345' | None 1992' |

Describe in detail the manner in which the well was plugged, indicating where the mud fluid was placed and the method or methods used in introducing it into the hold. If cement or other plugs were used, state the character of same and depth placed, from feet to feet for each plug set.

- 4346' to 4267' Cement
- 4267' to 250' Heavy Mud
- 250' to 205' Cement - 15 sacks
- 205' to 25' Heavy Mud
- 25' to 0' Cement - 10 sacks

15 26 12W
87 - 3-

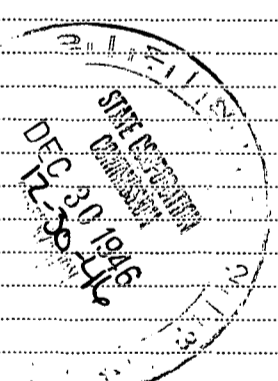

(If additional description is necessary, use BACK of this sheet)

Correspondence regarding this well should be addressed to **Sohio Petroleum Company**
Address **Box 609, Russell, Kansas**

STATE OF **Kansas**, COUNTY OF **Russell**, ss. **P. C. Musgrove**

(employee of owner) of (owner or operator) of the above-described well, being first duly sworn on oath, says: That I have knowledge of the facts, statements, and matters herein contained and the log of the above-described well as filed and that the same are true and correct. So help me God.

(Signature) *P. C. Musgrove*
Russell, Kansas (Address)

SUBSCRIBED AND SWORN to before me this **28th** day of **December**, 19 **46**

My commission expires **May 8, 1948**.

My commission expires

Bernie J. Smith
Notary Public.

15-151-00141-0000

CONTRACTOR'S VERIFIED LOG

Operator DOMIO PETROLEUM CO. Farm Name STALCUP Well No. 1

Location THE NE 1/4 OF SECTION 15-26-12, PRATT COUNTY, KANSAS

Pool Name _____ County PRATT State KANSAS

Commencement Date 9/23/46 Completion Date 10/3/46

LOG OF WELL

| Depth | | Formation | Deviation from Vertical (Degrees) | Remarks |
|-------|------|----------------------------|-----------------------------------|---------|
| From | To | | | |
| 0 | 45 | SAND | | |
| 45 | 167 | SHALE & SHALE | | |
| 167 | 235 | AMMONITE & SAND | | |
| 235 | 365 | RED BED & SHELLS | | |
| 365 | 445 | RED BED, SHALE & SHELLS | | |
| 445 | 715 | RED SHALE & SHELLS | | |
| 715 | 850 | SAND & AMMONITE | | |
| 850 | 1195 | SHALE & SHELLS | | |
| 1195 | 1425 | SHALE & SAND | | |
| 1425 | 1485 | SHALE & LIME | | |
| 1485 | 1755 | SHALE & SHALE | | |
| 1755 | 1910 | LIME | | |
| 1910 | 1940 | SHALE & SHELLS | | |
| 1940 | 1950 | LIME, SHALE, SHELLS | | |
| 1950 | 2160 | SANDY LIME & SHALE | | |
| 2160 | 2235 | LIME & SHALE | | |
| 2235 | 2325 | SHALE & LIME, SHELLS | | |
| 2325 | 2490 | LIME & SHALE | | |
| 2490 | 2550 | SANDY LIME | | |
| 2550 | 2705 | SHALE & LIME, SHELLS | | |
| 2705 | 2760 | LIME & SHALE | | |
| 2760 | 2855 | SHALE & SHELLS | | |
| 2855 | 2945 | LIME & SHALE SAND | | |
| 2945 | 3240 | LIME & SHALE | | |
| 3240 | 3565 | LIME | | |
| 3565 | 3605 | LIME & SHALE | | |
| 3605 | 4097 | LIME | | |
| 4097 | 4116 | SHALE | | |
| 4116 | 4130 | WINDHAMMER SHALE | | |
| 4130 | 4146 | VIOLET LIME | | |
| 4146 | 4169 | LIME & CHERT | | |
| 4169 | 4175 | VIOLET, CHERT | | |
| 4175 | 4224 | LIME & CHERT | | |
| 4224 | 4230 | HARD SAND | | |
| 4230 | 4257 | SIMPSON | | |
| 4257 | 4305 | SIMPSON SAND & SHALE | | |
| 4305 | 4308 | SAND & SHALE | | |
| 4308 | 4356 | ARBUCKLE LIME | | |
| 4356 | 4345 | CORRECTED TO DEBRICK FLOOR | | |

PLUGGING
 15 26 12 W
 LOG # 87 3

