


Give All Information Completely  
Make Required Affidavit  
Mail or Deliver Report to:  
Conservation Division  
State Corporation Commission  
P. O. Box 17027  
Wichita, Kansas 67217  
NORTH

WELL PLUGGING RECORD

Pratt County, Sec. 13 Twp. 26S Rge. 12 ~~W~~ W (W)

Location as "NE/CNW/SW" or footage from lines C SE NW  
Lease Owner PAR Petroleum, Inc.  
Lease Name Rundell Well No. 1  
Office Address 326 N. Lincoln Liberal, Kansas  
Character of Well (completed as Oil, Gas or Dry Hole) Dry Hole  
Date well completed June 29 1980  
Application for plugging filed June 29 1980  
Application for plugging approved June 29 1980  
Plugging commenced June 29 1980  
Plugging completed June 29 1980  
Reason for abandonment of well or producing formation Dry

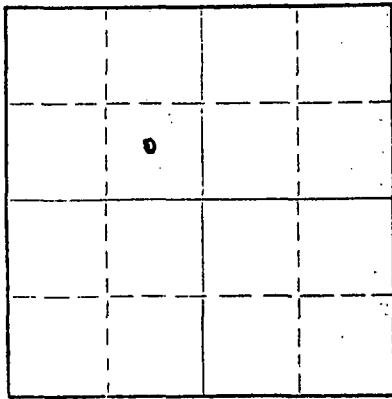

Locate well correctly on above  
Section Plat

If a producing well is abandoned, date of last production 19  
Was permission obtained from the Conservation Division or its agents before plugging was commenced? Yes

Name of Conservation Agent who supervised plugging of this well William T. Owen  
Producing formation None Depth to top Bottom Total Depth of Well 4300 Feet  
Show depth and thickness of all water, oil and gas formations.

OIL, GAS OR WATER RECORDS

CASING RECORD

FORMATION	CONTENT	FROM	TO	SIZE	PUT IN	PULLED OUT
Surface Sand	water	0	350'	8-5/8"	300'	None

Describe in detail the manner in which the well was plugged, indicating where the mud fluid was placed and the method or methods used in introducing it into the hole. If cement or other plugs were used, state the character of same and depth placed, from feet to feet for each plug set.

Cemented with class "H" cement. 40 sx of cement @ 540', 40 sx @ 300', wooden plug, 1 sx of hulls and 10 sx of cement @ surface, 5 sx of cement in rat hole and 2 sx of cement in water well.

RECEIVED  
STATE CORPORATION COMMISSION  
JUL - 8 1980  
7-8-80  
CONSERVATION DIVISION  
Wichita, Kansas

(If additional description is necessary, use BACK of this sheet)

Name of Plugging Contractor Dowell  
Address Great Bend, Kansas

STATE OF Kansas, COUNTY OF Seward, ss.  
Curtis F. Covington (employee of owner) or (owner or operator) of the above-described well, being first duly sworn on oath, says: That I have knowledge of the facts, statements, and matters herein contained and the log of the above-described well as filed and that the same are true and correct. So help me God

(Signature) Curtis F. Covington  
Curtis F. Covington  
326 N. Lincoln Liberal, Kansas  
(Address)

SUBSCRIBED AND SWORN TO before me this 7 day of July, 1980

Georgetta Taylor  
Notary Public.

My commission expires



KANSAS DRILLERS LOG

COMPANY Par Petroleum, Inc.  
FARM Rundell No.1

SEC. 13 T. 26S R. 12W  
LOC. C-SE NW

COUNTY Pratt

ROTARY TOTAL DEPTH 4,300'  
COMM. June 19, 1980 COMP. June 29, 1980  
CONTRACTOR H-30, Inc. (Rig #3)  
ISSUED July 7, 1980

CASING

10 3/4"  
8 5/8" Set at 305' cemented w/250 sxs cement  
5 1/2"  
4 1/2"

ELEVATION 1,876' K.B.

FIGURES INDICATE BOTTOM OF FORMATIONS

Sand	180'
Red Bed and Shale	938'
Lime and Shale	1,415'
Shale and Lime	1,660'
Lime and Shale	1,900'
Shale and Lime	2,430'
Lime and Shale	2,660'
Shale and Lime	2,795'
Lime and Shale	2,972'
Shale and Lime	3,170'
Lime and Shale	3,583'
Shale and Lime	3,665'
Lime and Shale	3,773'
Shale and Lime	3,905'
Lime and Shale	4,300'
Rotary Total Depth	4,300'


I hereby certify the above and foregoing to be  
a true and correct log of the above described  
well as shown by the drilling reports.

H-30, INC.

*Dean Britting*  
Dean Britting

State of Kansas )  
County of Sedgwick ) SS:

Subscribed and Sworn to before me a Notary Public  
in and for said county and state this 7th day of  
July, 1980.

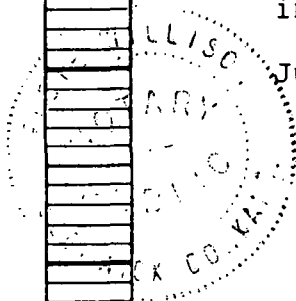

*Elsie Willison*  
Elsie Willison - Notary Public

My Commission Expires:  
July 25, 1982

RECEIVED  
STATE CORPORATION COMMISSION

JUL 11 1980  
7-11-80  
CONSERVATION DIVISION  
Wichita, Kansas