

15-151-20567-0000

STATE OF KANSAS
STATE CORPORATION COMMISSION

WELL PLUGGING RECORD

Give All Information Completely
Make Required Affidavit
Mail or Deliver Report to
Conservation Division
State Corporation Comm.
245 North Water
Wichita, KS 67202

Pratt County, Sec. 13 Twp. 26S Rge. 12 XX/W
Location as "NE/CNW $\frac{1}{4}$ SW $\frac{1}{4}$ " or footage from lines
NE SW SE

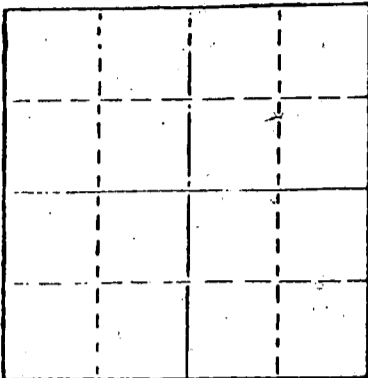
Lease Owner J. A. Allison
Lease Name Miskimen Well No. 1
Office Address Suite 305, 300 West Douglas, Wichita, Ks. 67202
Character of Well (Completed as Oil, Gas or Dry Hole)
Dry Hole

Date Well completed 11/11 1978
Application for plugging filed 11/11 1978
Application for plugging approved 11/11 1978
Plugging commenced 11/11 1978
Plugging completed 11/11 1978
Reason for abandonment of well or producing formation
Dry Hole

If a producing well is abandoned, date of last production
19

Was permission obtained from the Conservation Division or
its agents before plugging was commenced? yes

Name of Conservation Agent who supervised plugging of this well Bill Owens
Producing formation _____ Depth to top _____ Bottom _____ Total Depth of Well 4350'
Show depth and thickness of all water, oil and gas formations.



Locate well correctly on above
Section Plat

OIL, GAS OR WATER RECORDS

CASING RECORD

FORMATION	CONTENT	FROM	TO	SIZE	PUT IN	PULLED OUT
				8-5/8"	369'	-0-

Describe in detail the manner in which the well was plugged, indicating where the mud fluid was placed and the method or methods used in introducing it into the hold. If cement or other plugs were used, state the character of same and depth placed, from _____ feet to _____ feet for each plug set.

- 40 sacks cement @ 540'
- 40 sacks cement @ 240'
- 12 sacks cement @ 40'
- 3 sacks cement - rat hole

RECEIVED
STATE CORPORATION COMMISSION

DEC - 8 1978

12-8-78

CONSERVATION DIVISION
Wichita, Kansas

(If additional description is necessary, use BACK of this sheet)

Name of Plugging Contractor Eagle Drilling, Inc.

STATE OF Kansas COUNTY OF Sedgwick, ss.
James G. Gould (employee of owner) or (owner or operator)
of the above-described well, being first duly sworn on oath, says: That I have knowledge of the facts, statements, and matters herein contained and the log of the above-described well as filed and that the same are true and correct. So help me God.

(Signature) James G. Gould
James G. Gould, 1625 Vickers-KSB&T Bldg,
(Address) Wichita, Ks. 67202

SUBSCRIBED AND SWORN TO before me this 21st day of November, 1978

Carol Alexander
Carol Alexander Notary Public.

My commission expires April 7, 1980



DRILLER'S LOG

Operator: J. A. Allison
Well Name: Miskimen #1
Well Location: NE SW SE
Sec. 13-26S-12W
County, State: Pratt County, Kansas

Commenced: 10/30/78
Completed: 11/11/78

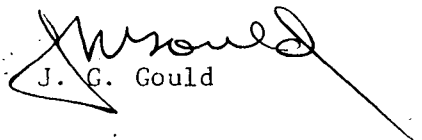
Surface Casing: Set 369', 20#, 8-5/8" new
w/275 sacks 3% cc 2% gel. Plugged down
4:00 A.M. 10/31/78

<u>FORMATION</u>	<u>DEPTH</u>
Sand	0 - 260
Red Bed	260 - 369
Red Bed & Shale	369 - 1630
Shale & Lime	1630 - 2165
Lime & Shale	2165 - 2432
Shale & Lime	2432 - 3282
Lime & Shale	3282 - 3802
Lime	3802 - 3835
Lime & Shale	3835 - 3870
Lime	3870 - 3919
Lime & Shale	3919 - 4036
Lime	4036 - 4162
Lime & Shale	4162 - 4215
Chert & Lime	4215 - 4243
Lime & Shale	4243 - 4336
Lime	4336 - 4350
	4350 - T.D.

RECEIVED
STATE CORPORATION COMMISSION
NOV 27 1978
11-27-78
CONSERVATION DIVISION
Wichita, Kansas

I do hereby certify that the foregoing statements are true and correct to the best of my knowledge and belief.

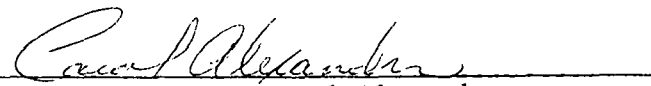
EAGLE DRILLING, INC.


J. G. Gould

STATE OF KANSAS)
COUNTY OF SEDGWICK) ss:

Subscribed and sworn to before me this 21st day of November, 78.

My appointment expires: 4/7/80


Notary Public, Carol Alexander

