


STATE OF KANSAS
STATE CORPORATION COMMISSION

WELL PLUGGING RECORD

Give All Information Completely
Make Required Affidavit
Mail or Deliver Report to:
Conservation Division
State Corporation Commission
800 Bittling Building
Wichita, Kansas

Pratt County. Sec. 18 Twp. 26S Rge. (E) 12 (W)

Location as "NE/CNWSW" or footage from lines SE NW NW
Lease Owner Natural Gas and Oil Corporation
Lease Name Webb Well No. 1
Office Address 1009 Central Building, Wichita 2, Kansas
Character of Well (completed as Oil, Gas or Dry Hole) dry hole
Date well completed April 18, 1954 19
Application for plugging filed April 18, 1954 (orally) 19
Application for plugging approved April 20, 1954 (written) 19
Plugging commenced April 18, 1954 19
Plugging completed April 18, 1954 19
Reason for abandonment of well or producing formation

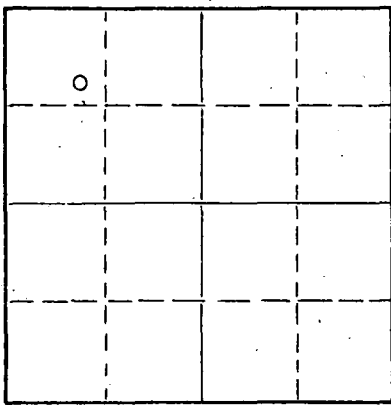

Locate well correctly on above Section Plat

If a producing well is abandoned, date of last production 19
Was permission obtained from the Conservation Division or its agents before plugging was commenced? yes

Name of Conservation Agent who supervised plugging of this well M. A. Rives, Box 8, Pratt, Kansas
Producing formation Depth to top Bottom Total Depth of Well Feet
Show depth and thickness of all water, oil and gas formations.

OIL, GAS OR WATER RECORDS

CASING RECORD

FORMATION	CONTENT	FROM	TO	SIZE	PUT IN	PULLED OUT
Surface	Sh-sd-shell	0	250	10 3/4"	250	none

Describe in detail the manner in which the well was plugged, indicating where the mud fluid was placed and the method or methods used in introducing it into the hole. If cement or other plugs were used, state the character of same and depth placed, from feet to feet for each plug set.

Filled hole with heavy mud from 4462 to 270 feet
Set plug at 270 feet and ran 25 sacks cement to 220 feet. Filled with heavy mud from 220 feet to 20 feet.
Set plug at 20 feet and capped with 10 sacks cement.

(If additional description is necessary, use BACK of this sheet)

Name of Plugging Contractor Drilling Department of Natural Gas and Oil Corporation
Address Route #1, Great Bend, Kansas

STATE OF Kansas, COUNTY OF Sedgwick, ss.
Claud L. Sheats (employee of owner) or (owner) of the above-described well, being first duly sworn on oath, says: That I have knowledge of the facts, statements, and matters herein contained and the log of the above-described well as filed and that the same are true and correct. So help me God.


(Signature) *Claud L. Sheats*
1009 Central Building, Wichita, Kans
(Address)

SUBSCRIBED AND SWORN TO before me this 21st day of April 1954

Esther L. Smith

My commission expires May 25, 1957

Notary Public.

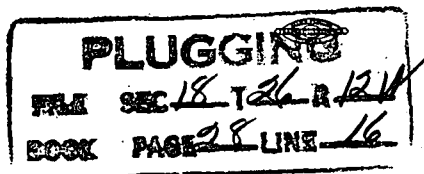

DRILLER'S LOG

COMPANY: Natural Gas and Oil Corporation
 CONTRACTOR: Drilling Department of
 Natural Gas and Oil Corporation
 FARM: Webb #1, SE NW NW Sec. 18-26S-12W
 Pratt County, Kansas
 COMMENCED: April 3, 1954
 COMPLETED: April 18, 1954
 elevation:- 1919 RB

 0 to 9 cellar
 9 to 25 Shale
 25 to 220 Sand
 220 to 250 Shale and shells
 250 to 345 Red bed
 345 to 760 Red bed and shells
 760 to 950 Shale and shells
 950 to 960 Anhydrite
 960 to 1275 Shale and shells
 1275 to 1710 Salt and shale
 1710 to 1915 Shale and lime
 1915 to 2035 Lime
 2035 to 3495 Shale and lime
 3495 to 3533 Lime
 3533 to 3610 Shale and lime
 3610 to 3650 Sand
 3650 to 3705 Shale
 3705 to 4028 Lime
 4028 to 4065 Lime W/shale
 4065 to 4190 Lime W/chert
 4190 to 4200 Shale
 4200 to 4206 Lime
 4206 to 4220 Chert
 4220 to 4247 Shale
 4247 to 4315 Lime and chert
 4315 to 4347 Simpson sand
 4347 to 4415 Lime and shale
 4415 to 4462 Arbuckle lime
 4462 T. D. (RB)

Set 250 feet of 10 3/4" surface. Cemented with 250 sacks cement and 4 sacks calcium chloride.

TOPS: Anhydrite	950	Lansing	3726	Viola	4200
Heebner	3532	Base KansasC	4027	Misener Sd	4190
Douglas	3604	Conglomerate	4131	Simpson Sd	4306
Brown Ls	3706	Mississippi	4145	Arbuckle	4415

DRILLSTEM TESTS:

- #1- 3873-3906, open 1 hr, fair blow, 240' gas in pipe, 60' slightly oil and gas cut mud, 60' gas cut mud w/spks oil, free oil in tool, SI 15 min, no IFP, no FFP, 650# BHP.
- #2- 4108-55, open 1 hr, fair blow, 240' gas, 33' drlg mud, SI 15 min, no IFP, no FFP, 80# BHP.
- #3- 4155-90, open 1 hr, good-fair blow, 60' gas in pipe, 65' gas cut mud w/few spks oil, SI 15 min, no IFP, no FFP, 160# BHP.
- #4- 4204-20, open 1 hr, very wk blow 4 min, weak intermittent blow 6 min, rec. 10' mud, bypass tool, SI 15 min, no pressures

No Schlumberger
 DRY, PLUGGED AND ABANDONED

RECEIVED
 STATE CORPORATION COMMISSION
 4-22-54
 APR 22 1954

CONSERVATION DIVISION
 Wichita, Kansas

PLUGGING
 FROM SEC. 18 T26 R 12 W
 DOG# PAGE 28 LINE 16

c e r t i f i c a t e

I, Claud Sheats, do hereby certify that the above and foregoing is a true and correct copy of the log of the Webb #1, SE NW NW Section 18-26S-12W, Pratt County, Kansas, as reflected by files of the Natural Gas and Oil Corporation.

Claud Sheats
Claud Sheats, Regional Geologist

Subscribed and sworn to before me, a Notary Public, within and for Sedgwick County, Kansas, this 21st day of April, 1954.

Esther Unsell
Esther Unsell, Notary Public

My commission expires May 25, 1957.

RECEIVED
STATE CORPORATION COMMISSION
APR 22 1954
4-22-54
CONSERVATION DIVISION
Wichita, Kansas