

15-151-10577-0000

STATE OF KANSAS  
STATE CORPORATION COMMISSION

WELL PLUGGING RECORD


OR

FORMATION PLUGGING RECORD

Strike out upper line when reporting plugging off formations.

Give All Information Completely  
Make Required Affidavit  
Mail or Deliver Report to:  
Conservation Division  
State Corporation Commission  
600 Bittling Building  
Wichita, Kansas

NORTH

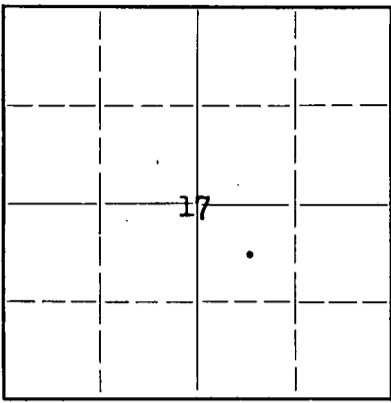

Locate well correctly on above Section Plat

Pratt County, Sec. 17 Twp. 26 Rge. (E) 12 (W)

Location as "NE1/4NW1/4SW1/4" or footage from lines C NW SE

Lease Owner Hollow Drilling Company, Inc.

Lease Name H. M. Huffman Well No. 1

Office Address Inman, Kansas

Character of Well (completed as Oil, Gas or Dry Hole) Dry Hole

Date well completed 8-10 1943

Application for plugging filed 8-10 1943

Application for plugging approved 8-11 1943

Plugging commenced 8-11 1943

Plugging completed 8-11 1943

Reason for abandonment of well or producing formation Dry Hole

If a producing well is abandoned, date of last production Dry Hole 19

Was permission obtained from the Conservation Division or its agents before plugging was commenced? Yes

Name of Conservation Agent who supervised plugging of this well C. T. Alexander

Producing formation -- Depth to top 4415 Bottom 4415 Total Depth of Well 4415 Feet

Show depth and thickness of all water, oil and gas formations.


OIL, GAS OR WATER RECORDS

CASING RECORD

Formation	Content	From	To	Size	Put In	Pulled Out
Arbuckle	Water	4393	4415	8 5/8"	385'	Left In

Describe in detail the manner in which the well was plugged, indicating where the mud fluid was placed and the method or methods used in introducing it into the hold. If cement or other plugs were used, state the character of same and depth placed, from feet to feet for each plug set.

Hole filled with mud from 4415' to 390'. Wood bridge at 390' and cemented with 15 sacks cement. Filled with mud from 355' to 26'. Wood plug and cemented with 6 sacks cement at 26' to 6' to top of cellar.

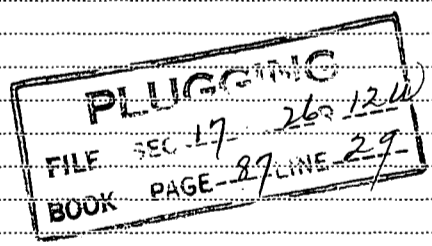

(If additional description is necessary, use BACK of this sheet)

Correspondence regarding this well should be addressed to Hollow Drilling Company, Inc. Inman, Kansas

STATE OF Kansas, COUNTY OF McPherson, ss. Frank Leach (employee of owner) or (owner or operator) of the above-described well,

being first duly sworn on oath, says: That I have knowledge of the facts, statements, and matters herein contained and the log of the above-described well as filed and that the same are true and correct. So help me God.

(Signature) Frank Leach Inman, Kansas (Address)

SUBSCRIBED AND SWORN to before me this 12 day of August 1943

My commission expires 9-14-46

G. P. Herbst 8-16-43 Notary Public

HOLLOW DRILLING COMPANY, Inc.

H. M. Huffman #1, C NW/4 SE/4  
 Section 17-26S-12W  
 Pratt County, Kansas  
 660' NL 660' WL

Elevation----- 1905 L&S

Casing Record: 8 5/8" cem @ 385' w/ 215' sax

Well Started----- 7-14-43

Well Completed--- 8-11-43

Rotary Tools ---- 0-4415 TD

Owner----- Hollow Drilling Company, Inc. et al  
 Inman, Kansas

Log

Formation Tops

0 10 Cellar  
 10 83 Clay  
 83 95 Shale  
 95 182 Sand  
 182 212 Red Clay  
 212 748 Red Rock  
 748 773 Sand  
 775 800 Red & Blue Shale  
 800 1285 Shale & Shells  
 1285 1300 Shale  
 1300 1440 Salt  
 1440 1657 Shale & Shells  
 1657 1686 Lime  
 1686 1725 Shale & Lime  
 1725 1860 Lime & Shale  
 1860 1950 Lime  
 1950 1993 Lime & Shale Breaks  
 1993 2098 Shale & Lime  
 2098 2140 Lime & Shale  
 2140 2168 Sand  
 2168 2200 Lime  
 2200 2245 Shale & Lime  
 2245 2408 Lime & Shale  
 2408 2435 Sandy Lime & Shale  
 2435 2450 Shale & Lime  
 2450 2530 Lime & Shale  
 2530 2550 Lime  
 2550 2595 Shale  
 2595 2874 Shale & Shells  
 2874 2944 Shale & Lime  
 2944 2989 Lime & Shale  
 2989 3015 Shale (Sticky)  
 3015 3105 Lime & Shale  
 3105 3124 Lime  
 3124 3160 Shale & Shells  
 3160 3170 Sand  
 3170 3198 Lime  
 3198 3248 Lime & Shale Breaks  
 3248 3275 Lime  
 3275 3300 Lime & Shale  
 3300 3510 Lime  
 3510 3542 Shale & Shells  
 3542 3576 Lime  
 3576 3612 Shale & Shells  
 3612 3650 Lime  
 3650 3676 Lime & Shale  
 3676 3679 Shale  
 3679 3696 Broken Lime  
 3696 3800 Lime  
 3800 3809 Cherty lime  
 3809 3821 Lime & Shale  
 3821 3834 Lime  
 3834 3840 Lime & Chert  
 3840 3856 Lime Broken  
 3856 3869 Lime & Chert  
 3869 3883 Cherty Lime & Shale

Kansas City	3624
Mississippi	4101
Viola	4198
Simpson	4281
Arbuckle	4393
3883 3916	Lime
3916 3956	Lime & Chert
3956 3972	Shale
3972 4015	Lime
4015 4045	Broken Lime
4045 4053	Lime & Chert
4053 4077	Chert & Shale
4077 4090	Lime
4090 4100	Lime & Shale
4100 4130	Lime & Chert
4130 4166	Chert
4166 4174	Chert & Shale
4174 4186	Shale & Chert
4186 4199	Shale
4199 4224	Chert
4224 4232	Lime & Chert
4232 4239	Chert
4239 4243	Shale
4243 4271	Lime & Chert
4271 4297	Lime
4297 4312	Shale
4312 4329	Sand
4329 4395	Shale
4395 4415	Lime
4415	T.D.

PLUGGING  
 FILE 17 26 12W  
 BOOK 27 29

STATE CORPORATION COMMISSION  
 AUG 16 1943  
 8-16-43  
 GEORGE W. HENRY  
 KANSAS

This certifies that this is a true and correct copy of the log of the H. M. Huffman #1, as described above.

*Paul Carl*